


T. 4 N., R. 29 E., W. M.

G9402


62464
62494

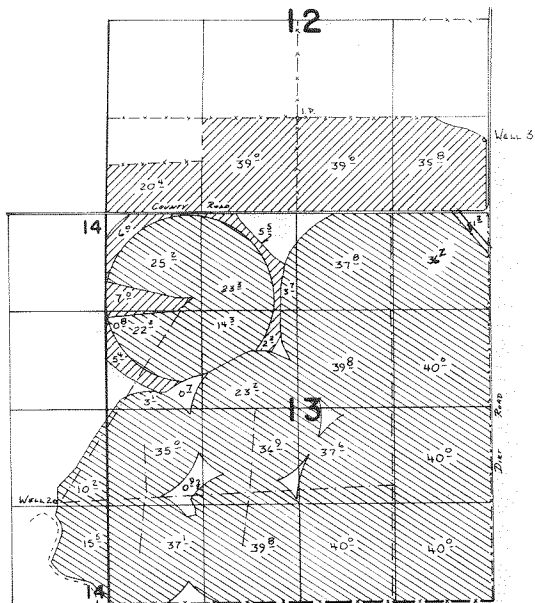


SCALE 1" = 1320'

Well 2 Located 1450' N. & 730' W. From SE. Cor. Sec. 14
Well 3 Located 1000' N. & 60' W. From SE. Cor. Sec. 12

FINAL PROOF SURVEY
UNDER

 Per. G-9648

 Per. G-9402

G-10479 G-9648
Application No. G-9536 Permit No. G-9402
IN NAME OF

LAWRENCE R. B. GLADYS ELAINE MORSE

Surveyed March 5 1984, by V. L. Church
1-10 85 V. L. Church

FL 8A-19
FL 8A-17