


T. 1 S., R. 14 E., W. M.

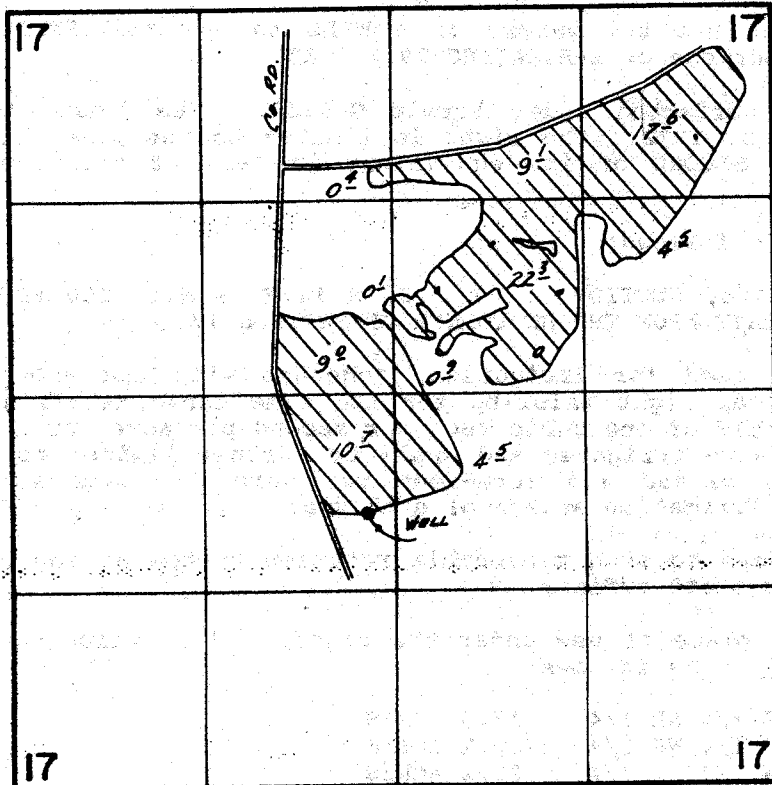

WELL LOC: 1050 N. & 2440 E. FROM SW COR. SEC. 17.

SCALE: 1" = 1320'

**FINAL PROOF SURVEY**  
UNDER

Application No. G-10640 Permit No. G-9755.....  
IN NAME OF

.....WILLIAM L. BOLTON.....

Surveyed Aug. 11, 19.87, by V. L. CHURCH.....

2/2/88 200  
41065-179-119 R