


T. 7 S., R. 2 W., W. M.

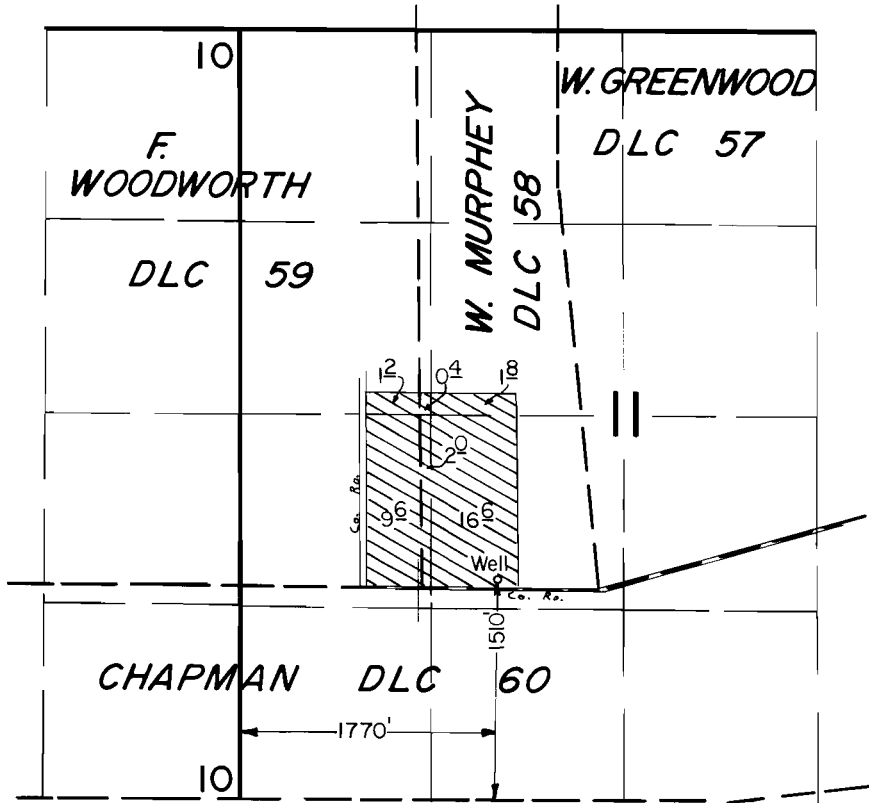

Scale : 1" = 1320'

**FINAL PROOF SURVEY**  
UNDER

Application No. G-11255. Permit No. G-10377...

IN NAME OF

**HARLAN SCHURTER**

Surveyed April 16, 1986, by T.M. Warren.....