


T.7S.,R.2W., W.M.

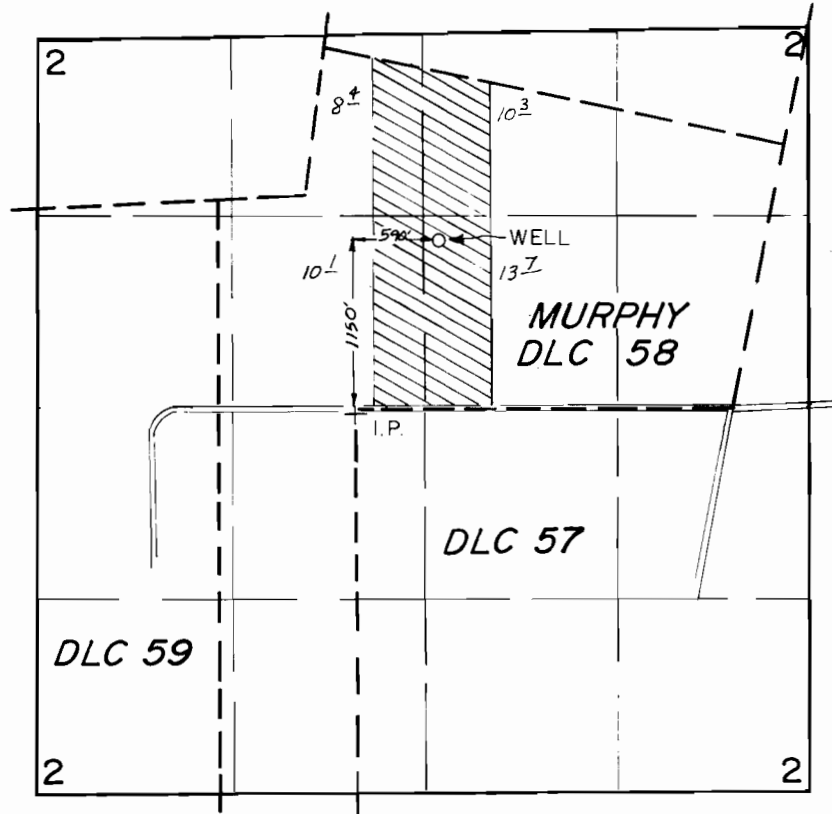

SCALE: 1" = 1320'

**FINAL PROOF SURVEY**  
UNDER

Application No. G-11268 Permit No. G-10379  
IN NAME OF

**HARLAN SCHURTER**

Surveyed AUG. 15 19 85, by B.W. BISHOP