


T.25S., R.12W., W.M.

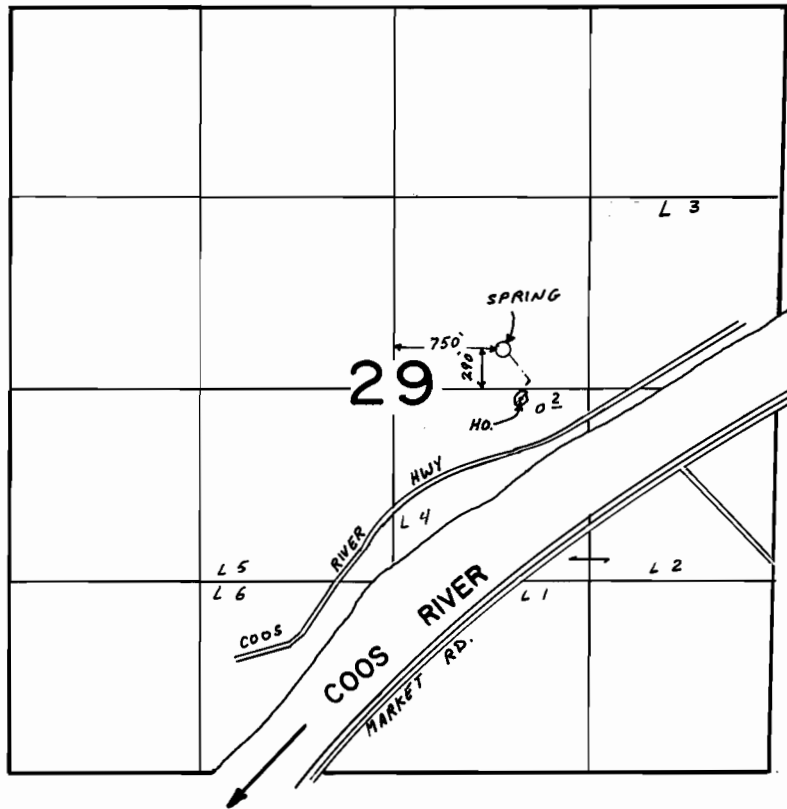

SCALE 1" = 1320'

### FINAL PROOF SURVEY

UNDER

50360

37314

Application No. 61249 Permit No. 45616

IN NAME OF

PAUL SHOOK

Surveyed JUN. 22 1987., by M. SCHMORDE

41011-180-238 B  
6-15-89 z.f.s.