


T.28S., R.8W., W.M.

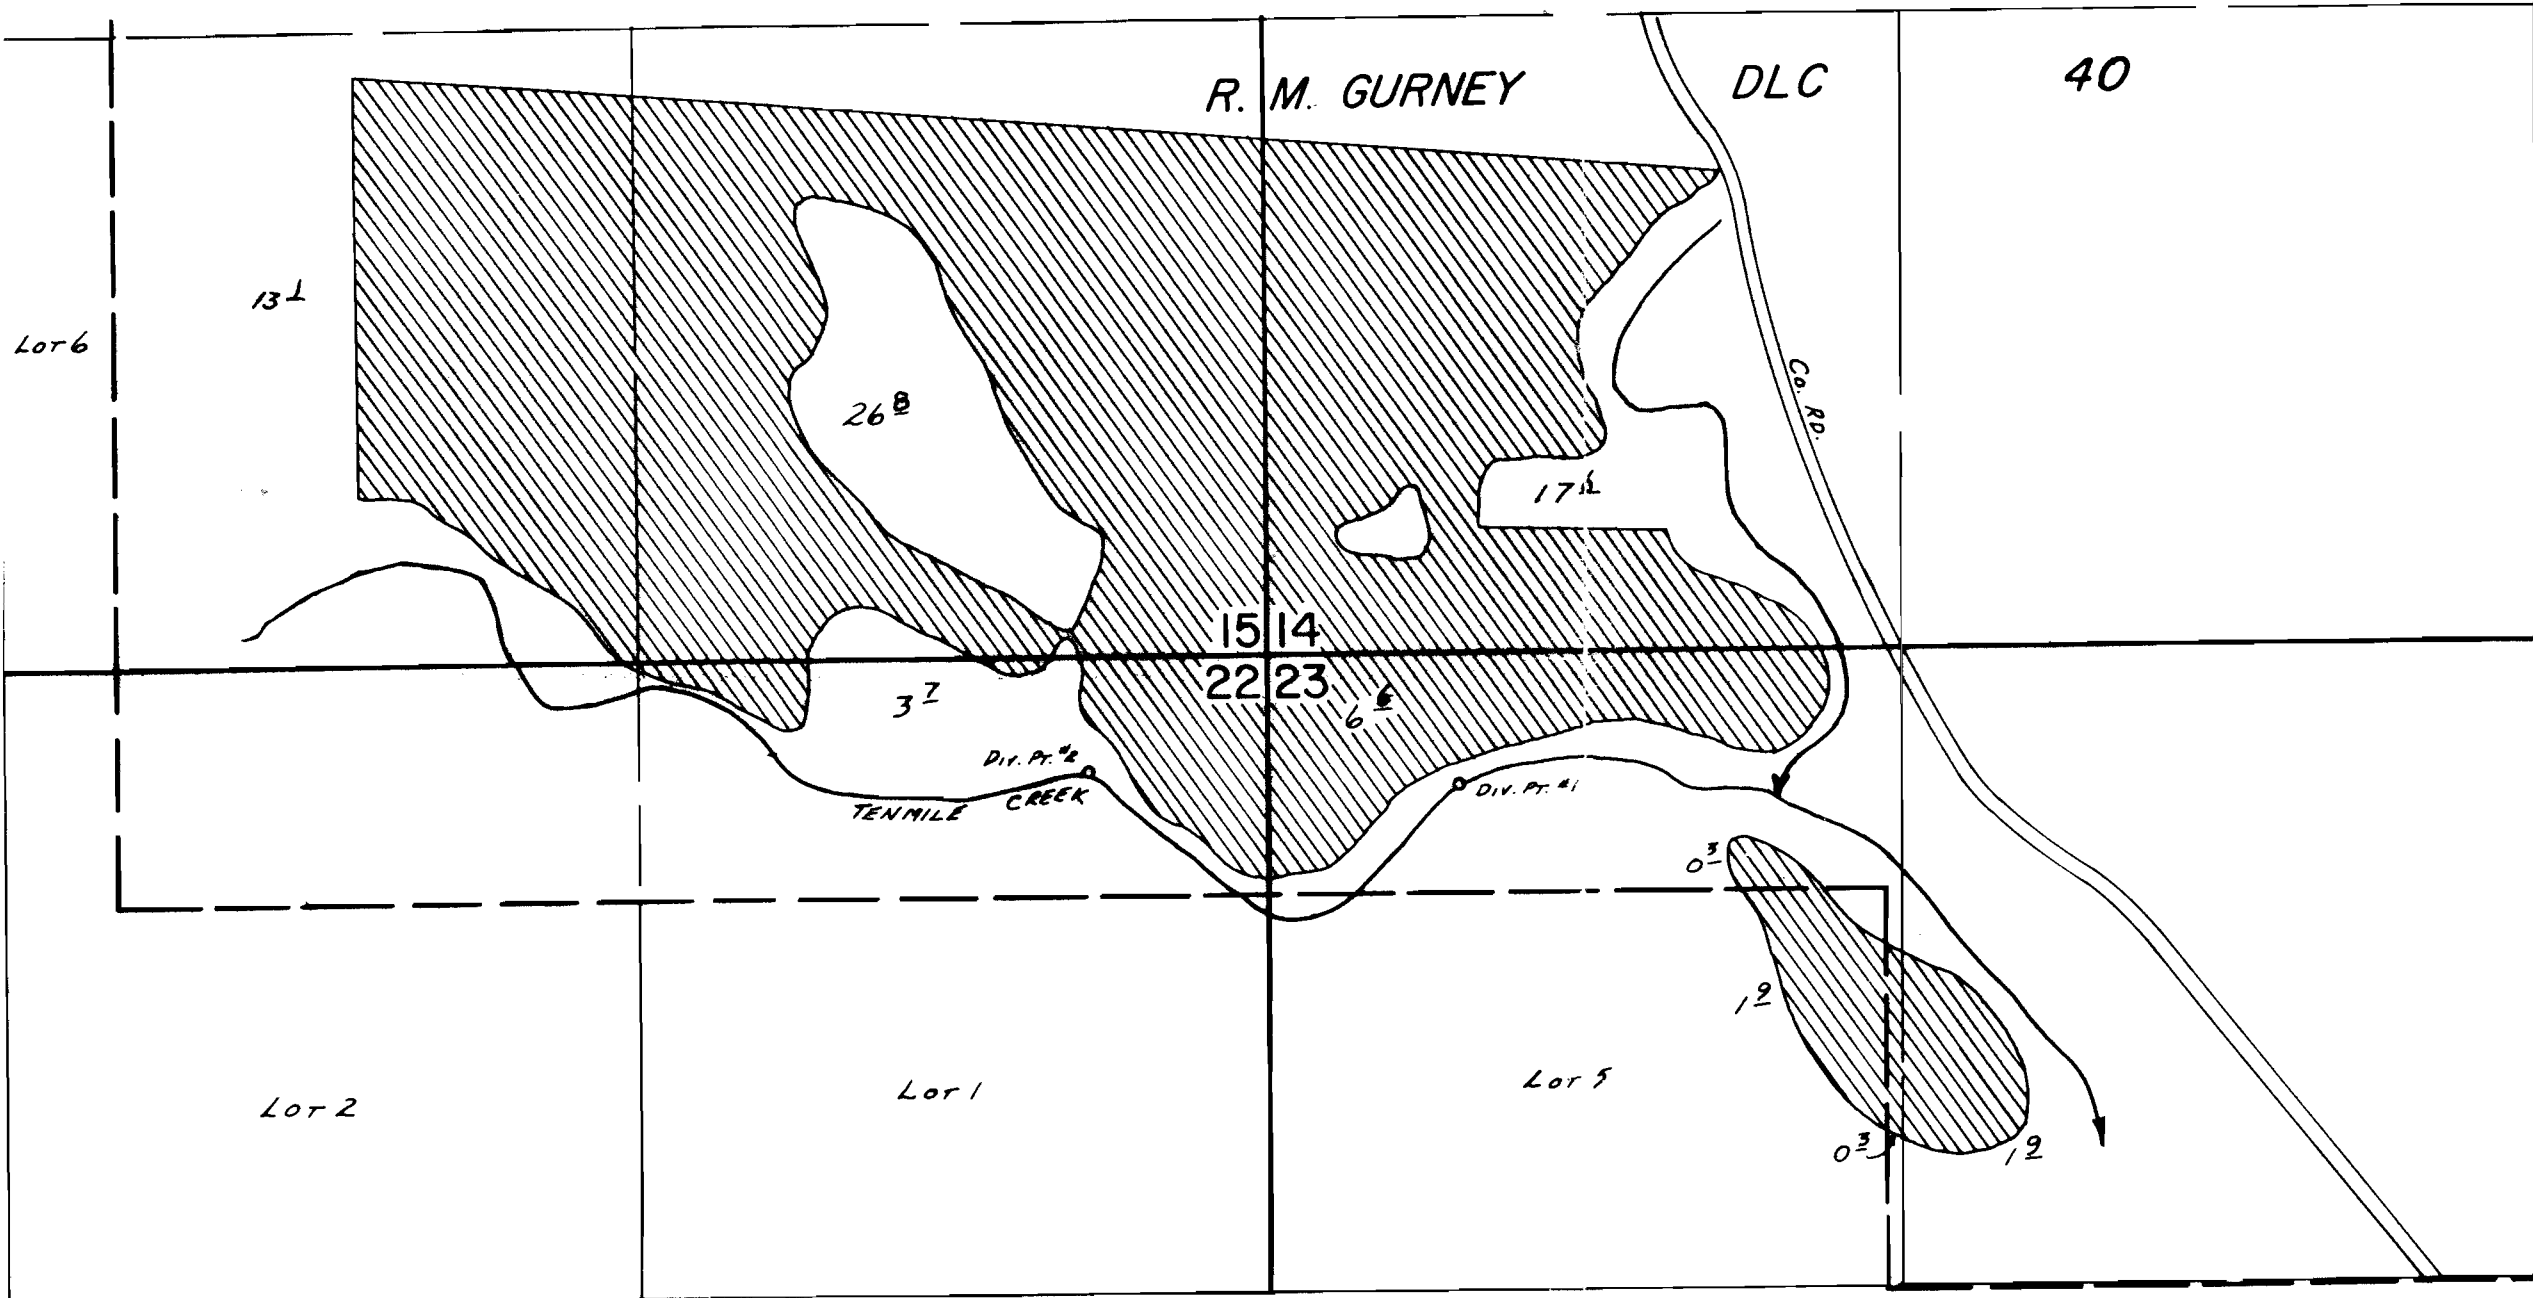

Div. Pts. Loc.: #1- 275 S. & 400 E.; #2- 240 S. & 375 W., BOTH FROM NW COR. SEC. 23.

SCALE: 1" = 400'

FINAL PROOF SURVEY
UNDER

Application No. 50946. Permit No. 37861.....
IN NAME OF

STUART & MARGARET LAWRENCE

Surveyed APR. 2... 1980, by J.S. DONALDSON