


T.6S. R.2E. W.M.

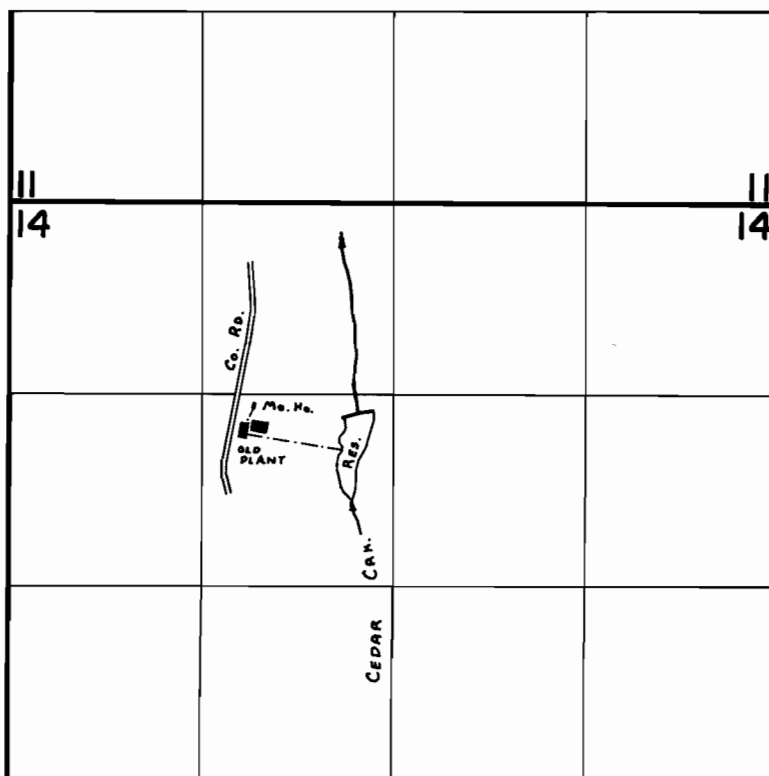

DAM Loc: 1450'S. & 2400'E. fr. N.W. Cor. Sec. 14.

FINAL PROOF SURVEY UNDER

R-51373 R-6035
Application No. 51374 Permit No. 37146
IN NAME OF

DEPT. OF VETERANS AFFAIRS

Surveyed Oct. 16, 1979, by C. L. HUGHES