




T. 1 S., R. 5 E., W.M.

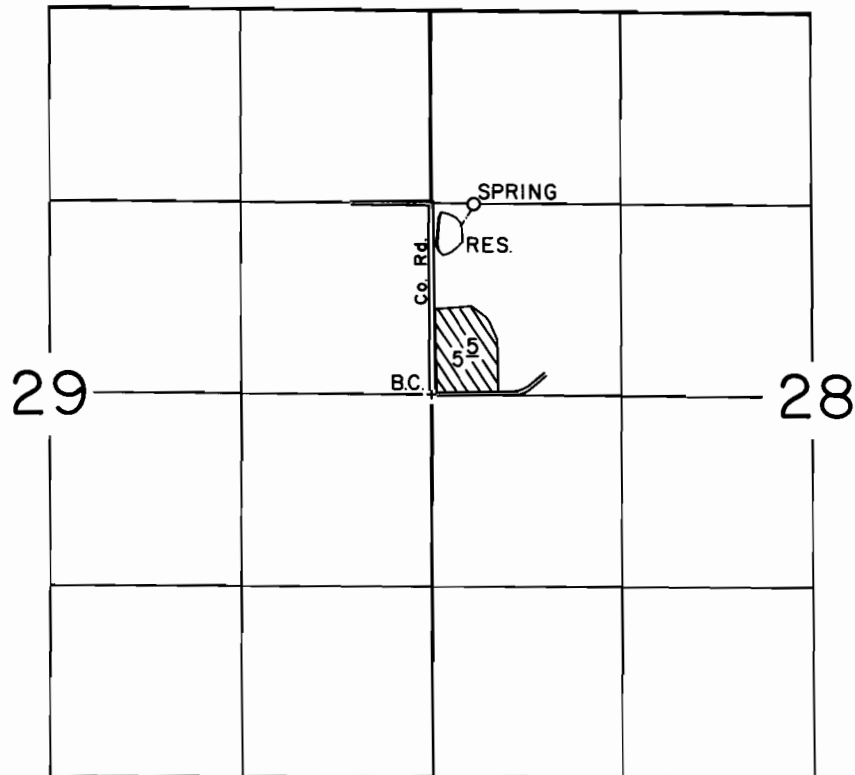

SPR. LOC.: 1310' N. & 300' E.,
DAM LOC.: 1100' N. & 50' E. BOTH FROM W. 1/4 CORNER SECTION 28

SCALE: 1" = 1320'

FINAL PROOF SURVEY

UNDER

R-52845 R-6367
Application No. 53442. Permit No. 39615
IN NAME OF

JOHN W. MARSH, JR.

Surveyed OCT. 10, 1986, by T. M. WARREN