


# T. 26 S., R. 11 W., W.M.

## SECTION 29

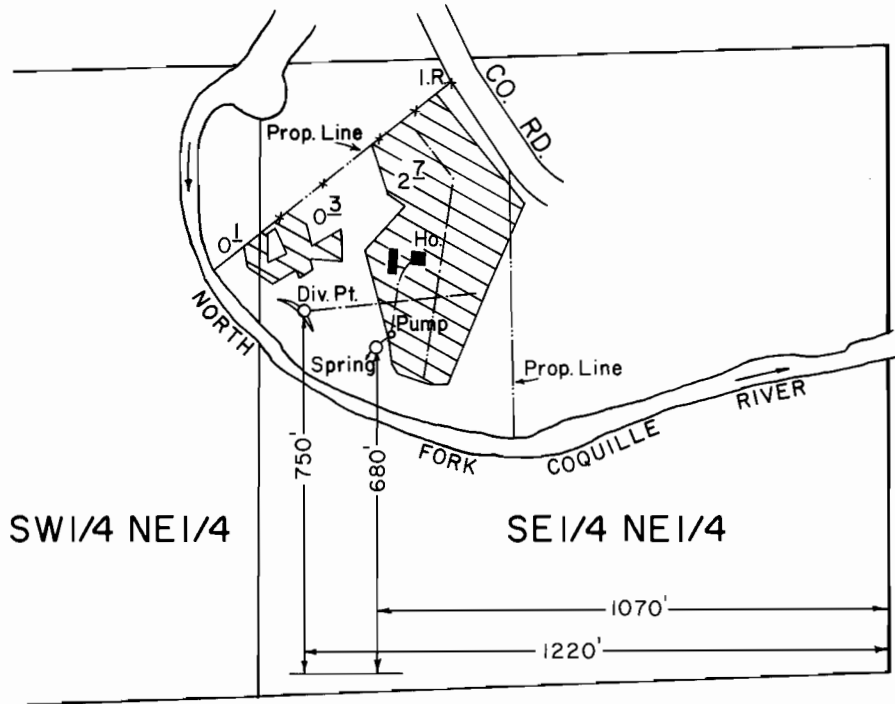

SCALE: 1" = 400'

### FINAL PROOF SURVEY UNDER

Application No. 53228 Permit No. 39500  
IN NAME OF

CALVIN CHRISTENSEN

Surveyed OCT. 10 1979, by S. DONALDSON  
SEPT. 21 1988, by Z. SALEH