


# T. 25 S., R. 12 W., W.M.

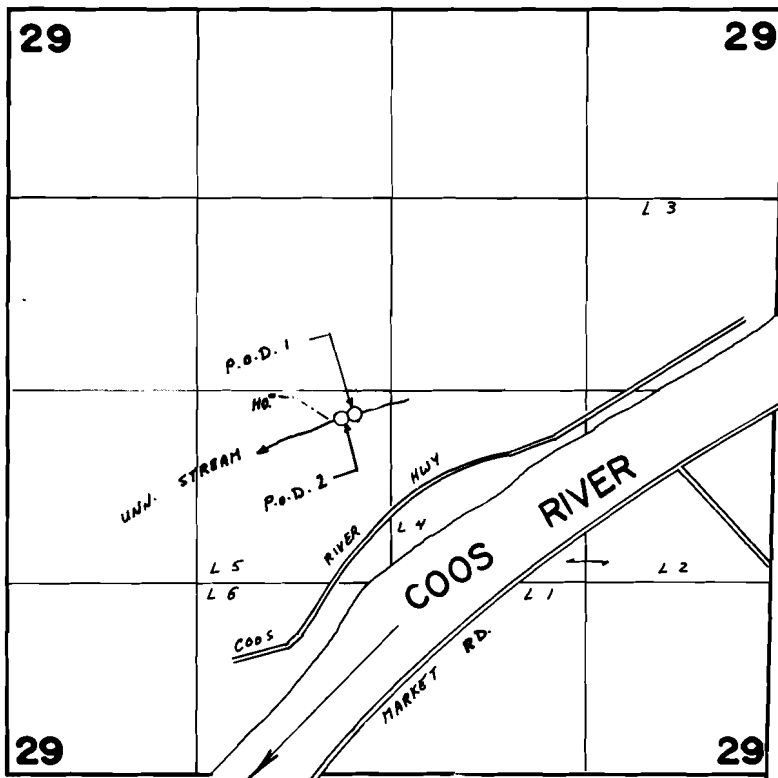

P.O.D. #1 170' S AND 260' W } BOTH FROM CENTER SEC. 29  
 P.O.D. #2 200' S AND 340' W }

SCALE 1" = 1320'

## FINAL PROOF SURVEY UNDER

Application No. **54433** Permit No. **40820**  
 IN NAME OF

**CLINTON CHARLES CRAWFORD**

Surveyed JUN. 23. 19.87., by ..M.....SCHMORDE

41 011-180-236 D  
 6-19-89 J.F.S.