


T.3S., R.3W., W.M.

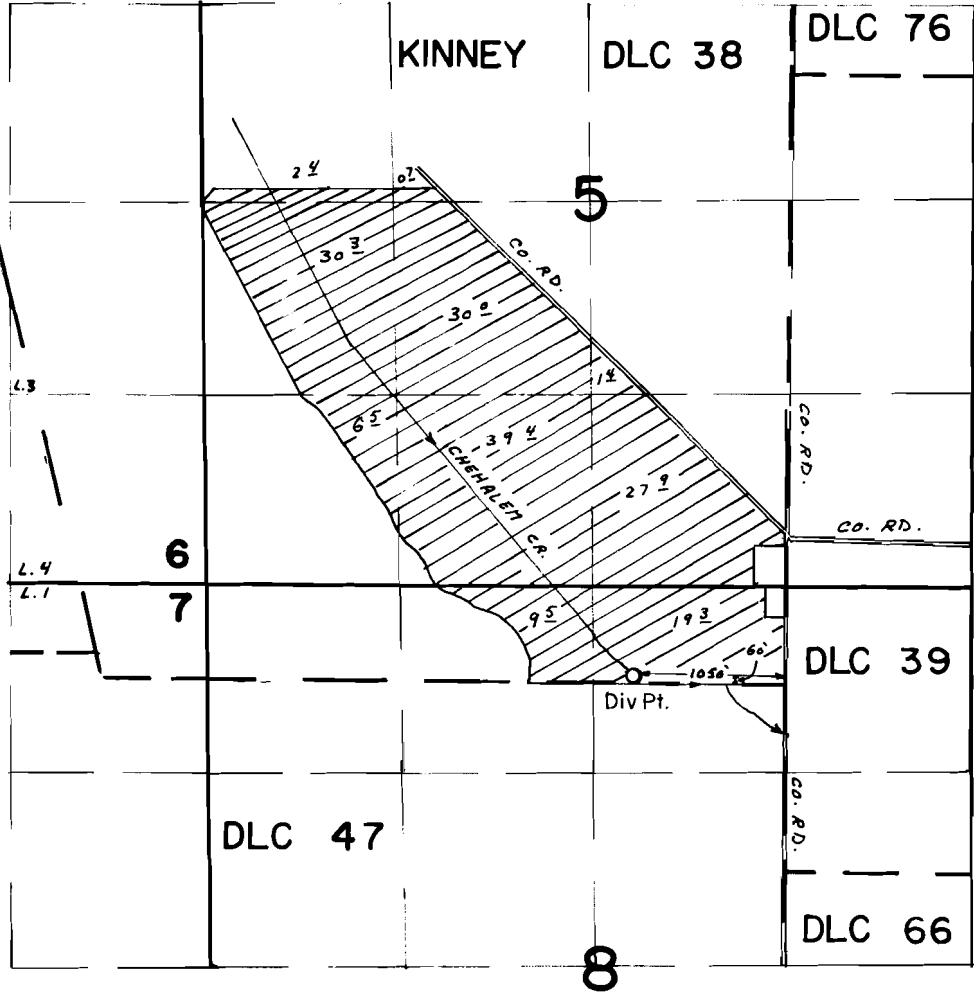

FINAL PROOF SURVEY UNDER

SCALE 1" = 1320'

Application No. **54599**... Permit No. **40968**.....

IN NAME OF

RON TANKERSLEY

Surveyed **SEP. 7**, 19**88**, by **Z. SALEH**.....

41071-178-113A
5-31-89 Z.F.S.