




T. 7 S., R. 3 W., W.M.

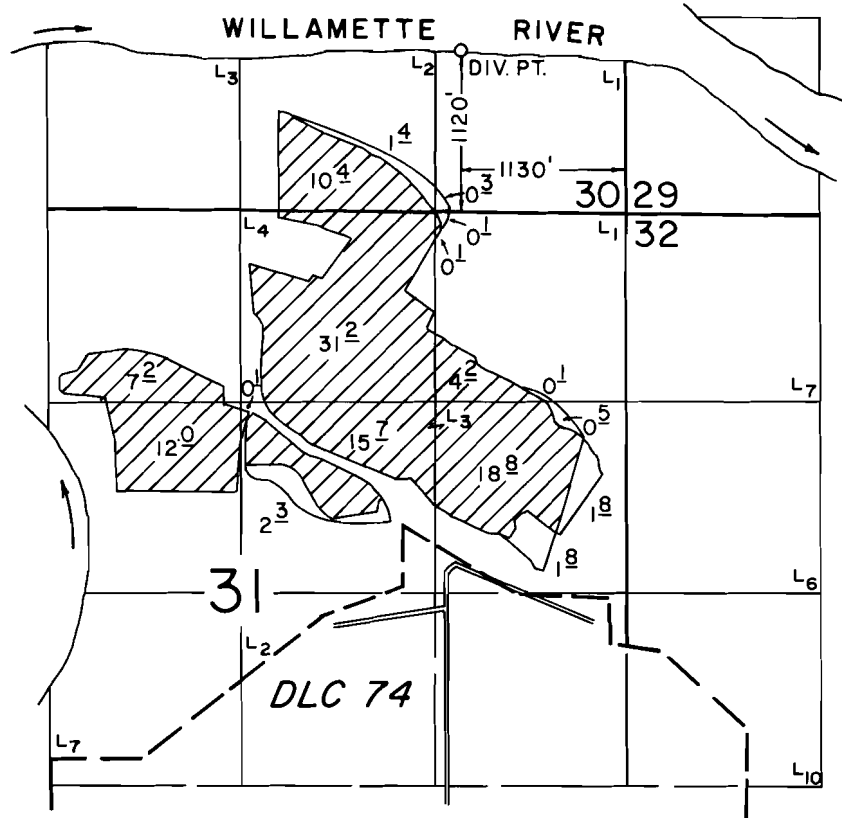

SCALE: 1" = 1320'

**FINAL PROOF SURVEY**  
UNDER

Application No. 55494. Permit No. 41835.....  
IN NAME OF

KARL HEYDEN

Surveyed APRIL 11, 1986., by T. M. WARREN.