

WARNING
SEWAGE DISPOSAL AREA
NO TRESPASSING
 BY ORDER OF
 CITY OF BOARDMAN

3" RED
 2" BLACK
 2" BLACK
 1" BLACK
 1" BLACK

PROVIDE 4 - 1/4" HOLES

- SIGN NOTES**
- 1) WARNING SIGNS TO BE PLACED AT 150' INTERVALS ALONG ACCESS CONTROL FENCE & ATTACHED TO FENCE W/ GALVANIZED WIRE
 - 2) SIGNS SHALL BE ALUMINUM, SIMILAR TO STANDARD HWY. SIGNS.
 - 3) BORDER - 5/8" BLACK MARGIN - 3/16" ALL CORNER 1/2" RADIUS
 - 4) NO. OF SIGNS REQ'D - 110 EXTRA SIGNS (APPROX. 50) TO BE DELIVERED TO THE CITY.

APPROXIMATE IRRIGATION AREA
FEEDWORK

* ASSUMED BREAKAGE FACTOR = 15%. ALL QUANTITIES ARE IN PLACE VOLUME OR AREA

CLEARING & GRADING 48 ACRES
 ACCESS CONTROL FENCE 8100 LIN. FT.

SW 1/4 NE 1/4
 25.0 ac.

IRRIGATION MAIN LINE
 SEE SHT. 10 FOR LOCATION & SIZE

END FORCE MAIN
 BID ITEM
 BEGIN LAGOON PIPING
 BID ITEM

PROVIDE 300' x 16' x 4' 3/4" MINUS SURFACE ROCK ON EXISTING GRAVEL BASE

CONSTRUCT 80' ACCESS ROAD OF 3/4" CRUSHED GRAVEL


CONSTRUCT 80' ACCESS ROAD OF 3/4" CRUSHED GRAVEL

SERVICE BLDG 4
 CHLORINATION BASIN

PROVIDE 445 YD² 3/4" CRUSHED GRAVEL PARKING SURFACE. 6" MIN. DEPTH. GRADE ACCESS TO PIKE TOP

CITY OF BOARDMAN, OREGON
 SEWERAGE TREATMENT FACILITY
 ERECT PROJECT

WATER RESOURCES DEPARTMENT
 APPROVED: *[Signature]* 19/11
[Signature]
[Signature]

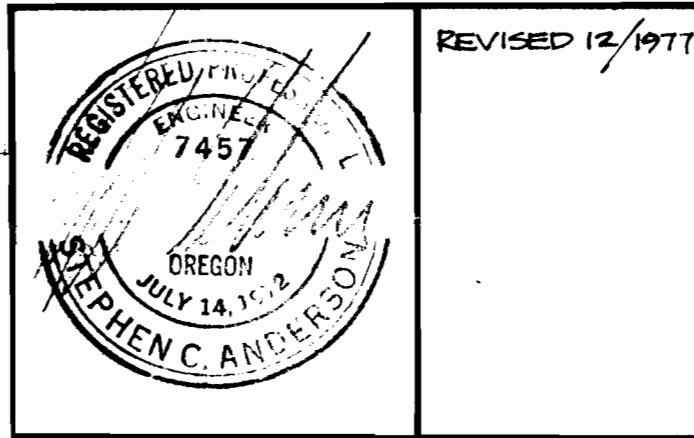

anderson perry & associates, inc.
 engineers - surveyors - materials testing
 LA GRANDE • ENTERPRISE • OREGON

LAGOON SITE PLAN	
BOARDMAN SEWERAGE IMPROVEMENTS	
WALLULIS & ASSOCIATES ENGINEERING & PLANNING	
DES. BY SGW	DATE 8-10-76
DR. BY JWM	REV. 8/11/76
CK. BY SGW	SHEET 10
REVISIONS	SCALE 1" = 100'

Application No. 47091
 Permit No. R 8517 47091

LEGEND


● EXISTING 1/2" STEEL PROPERTY PIN

NOTE:

1) THE ACCESS CONTROL FENCE SHALL BE CONSTRUCTED 1' INSIDE THE PROPERTY LINE. THE CONTRACTOR SHALL AVOID DISTURBING EXISTING PROPERTY PINS IF POSSIBLE. THE CONTRACTOR SHALL NOTIFY THE ENGINEER PRIOR TO DISTURBING ANY PROPERTY PINS IN ORDER THAT THE ENGINEER MAY SET APPROPRIATE REFERENCE POINTS BY WHICH THE CONTRACTOR SHALL REPLACE THE PIN. THE CONTRACTOR SHALL RESET DISTURBED PINS IN THEIR ORIGINAL POSITIONS W/ CONCRETE ANCHORS AS APPROVED BY THE ENGINEER.

BM #6 ELEV 319.44

B.P.A. SUBSTATION

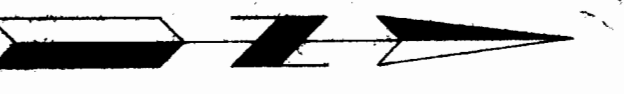

REVISED 12/1977

DEPARTMENT OF WATER RESOURCES
 DO NOT SEND OUT