


T. 4S., R. 2W., W.M.

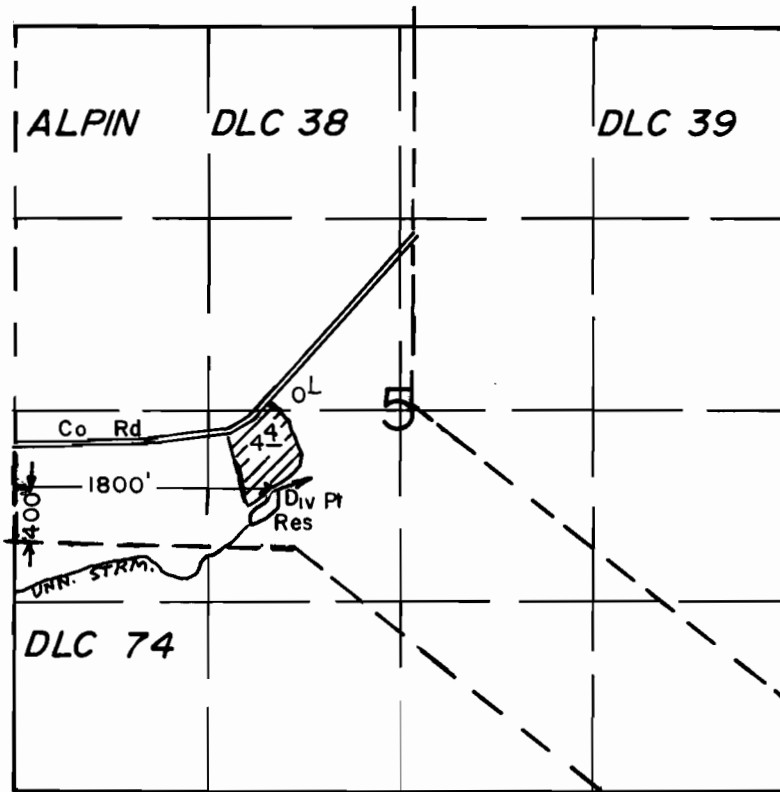

SCALE: 1"=1320'

FINAL PROOF SURVEY
UNDER

R - 57309 R - 7669
Application No. 57310... Permit No. 43301.....
IN NAME OF

WALTER L. SPROGIS

Surveyed .AUG.28. 19.79., by S.C. BROWN.....