


T. 4S., R. 2W., W.M.

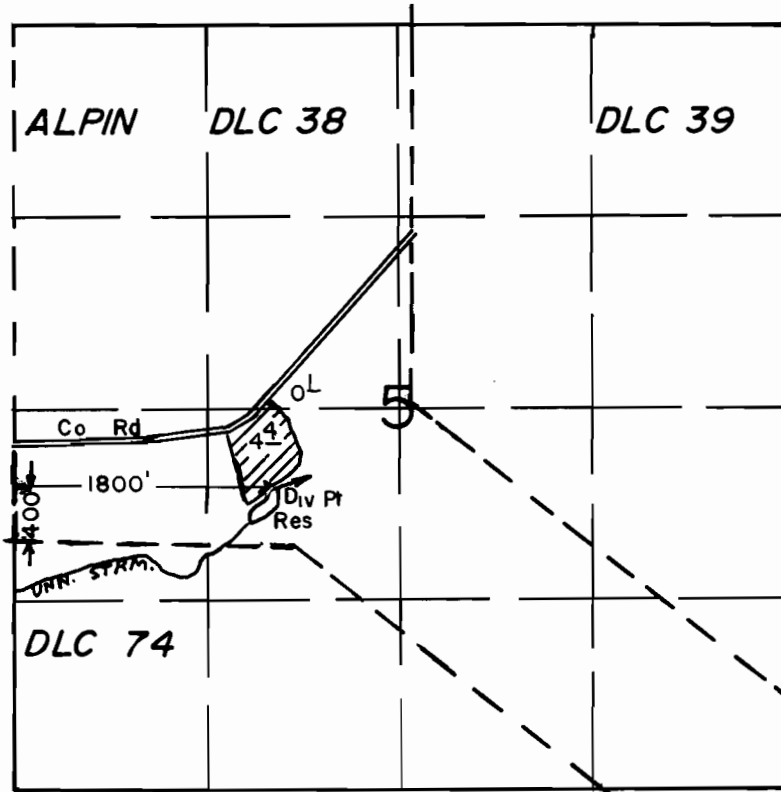

SCALE: 1"=1320'

**FINAL PROOF SURVEY**  
UNDER

R - 57309                      R - 7669  
Application No. 57310... Permit No. 43301.....  
IN NAME OF

.....**WALTER L. SPROGIS**.....

Surveyed .AUG.28. 19.79., by .S.C..BROWN.....