



T. 7 S., R. 4 W., W.M.

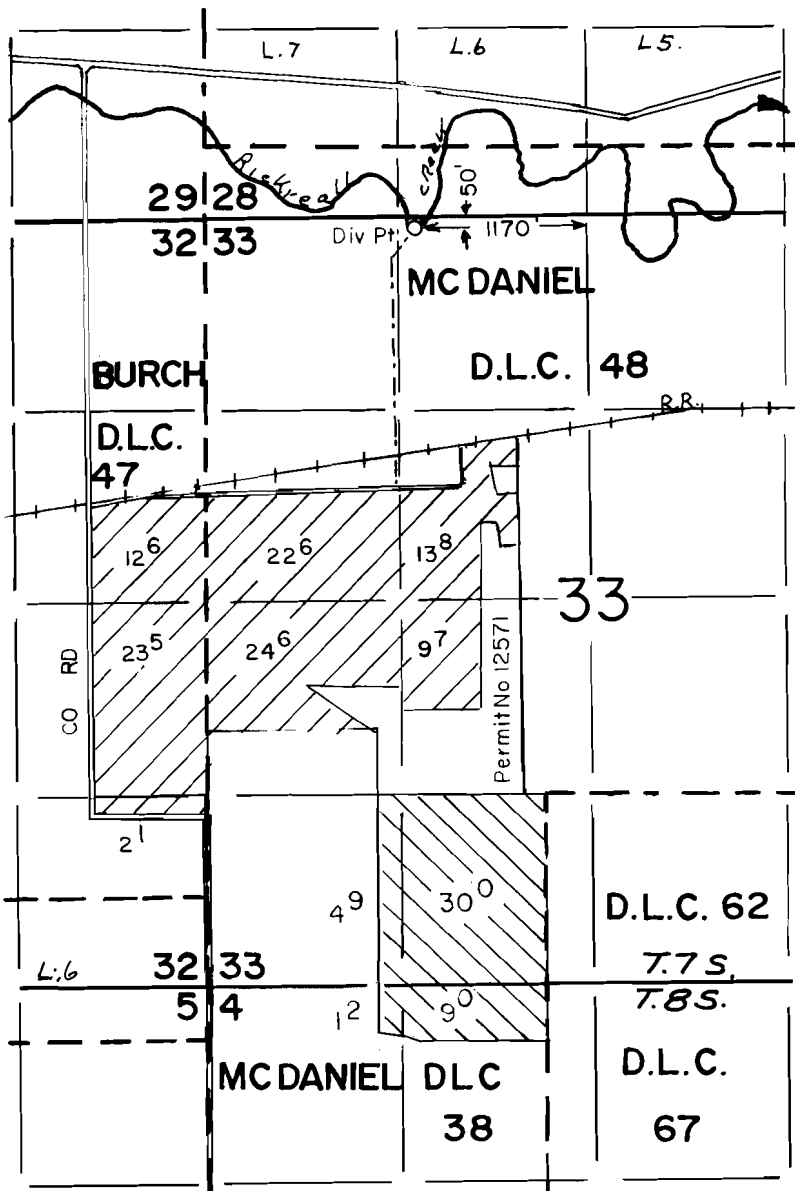

SCALE: 1" = 1320'

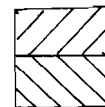

Permit No 44306
Transfer No 4184

FINAL PROOF SURVEY

UNDER

TRANSFER NO 4100

TRANSFER NO 4184

Application No. 58.481.... Permit No. 44306.....

IN NAME OF

.....**MARVIN C. JENKINS**.....

Surveyed MAY 6..... 19.87., by B.W. BISHOP.....