




T. 24 S., R. 13 W., W.M.

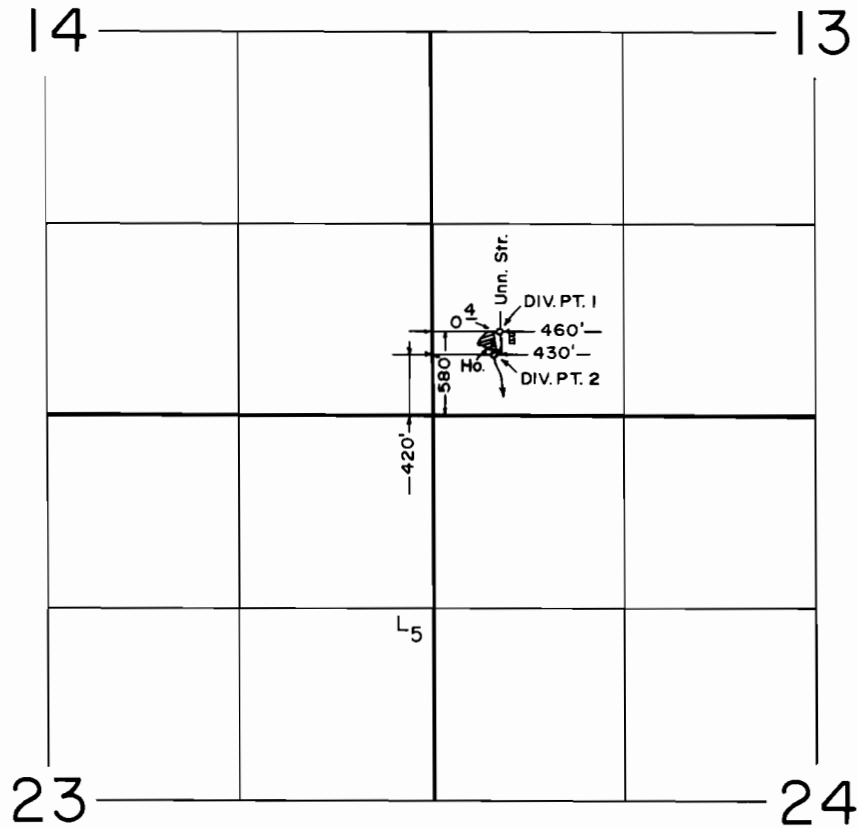

SCALE: 1" = 1320'

FINAL PROOF SURVEY
UNDER

Application No. 60157... Permit No. 45162.....
IN NAME OF

RICHARD HARLEN LUCAS SR.

Surveyed SEPT. 17, 1988, by V. L. CHURCH.