


T. 6S., R. 5W., W. M.

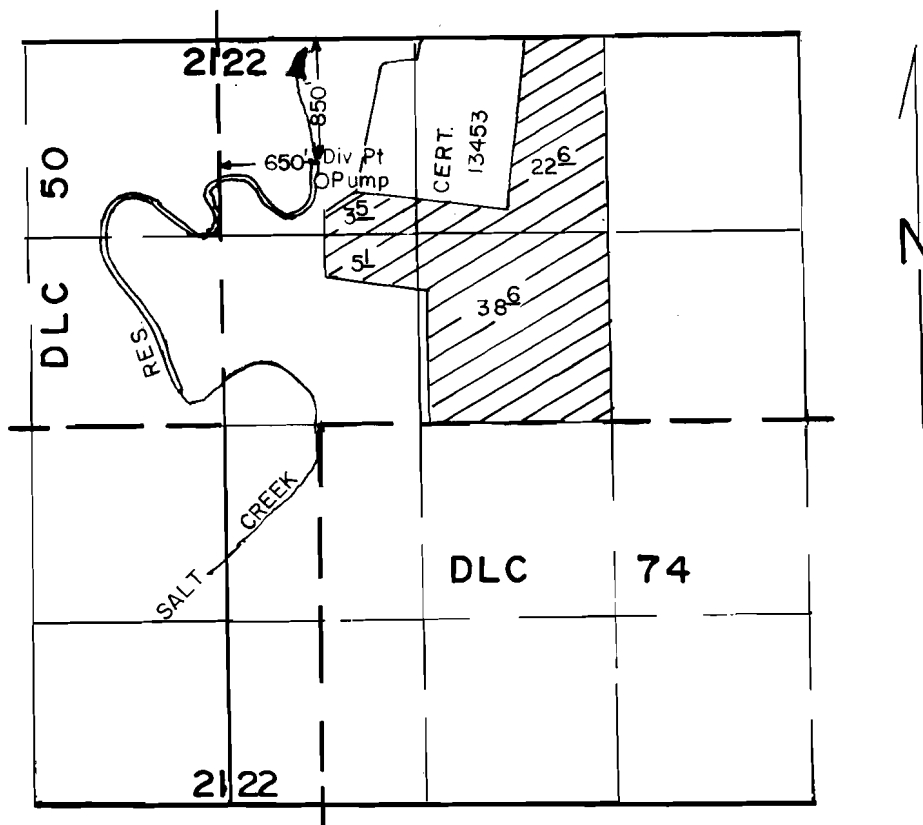

SCALE: 1" = 1320'

FINAL PROOF SURVEY
UNDER

R- 60450 R- 8159

Application No. 60451..... Permit No. 44265.....

IN NAME OF

ROBERTA JANSEN

Surveyed JUNE 17.... 1987., by .B.W. BISHOP.....