


T. 6S., R. 5W., W. M.

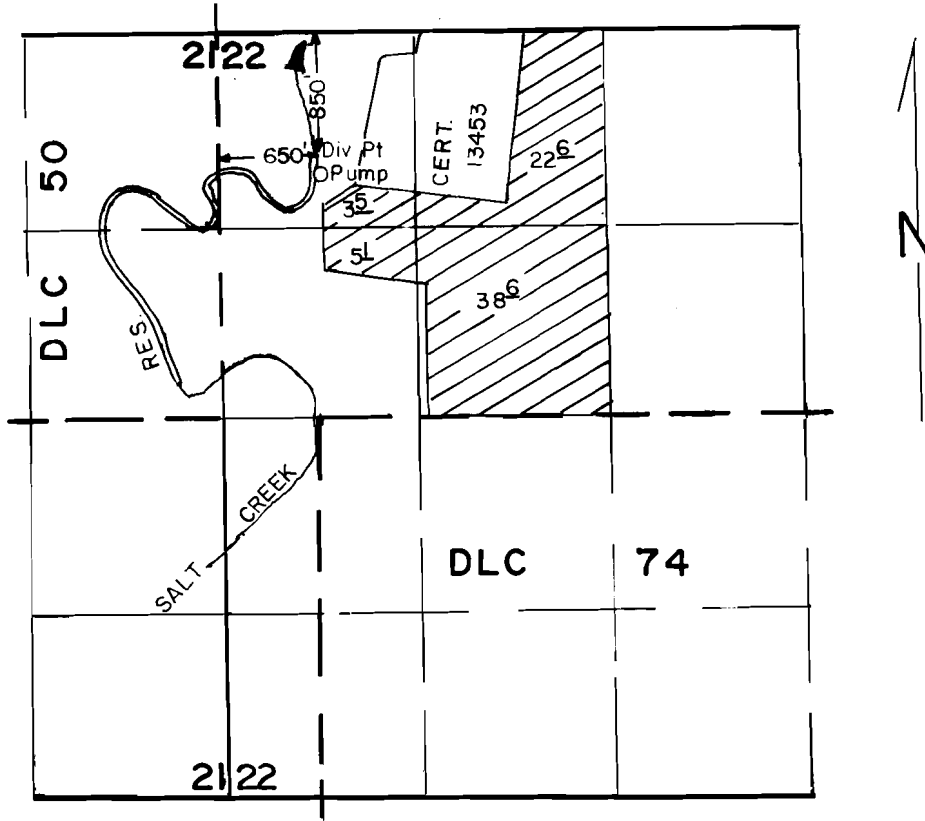

SCALE: 1" = 1320'

**FINAL PROOF SURVEY**  
UNDER

R- 60450

R- 8159

Application No. 60451..... Permit No. 44965.....

IN NAME OF

.....**ROBERTA**..... **JANSEN**.....

Surveyed **JUNE 17**.... **1987**., by **B.W. BISHOP**.....