


P-46285
C-62528

T.14S., R.33E., W.M.

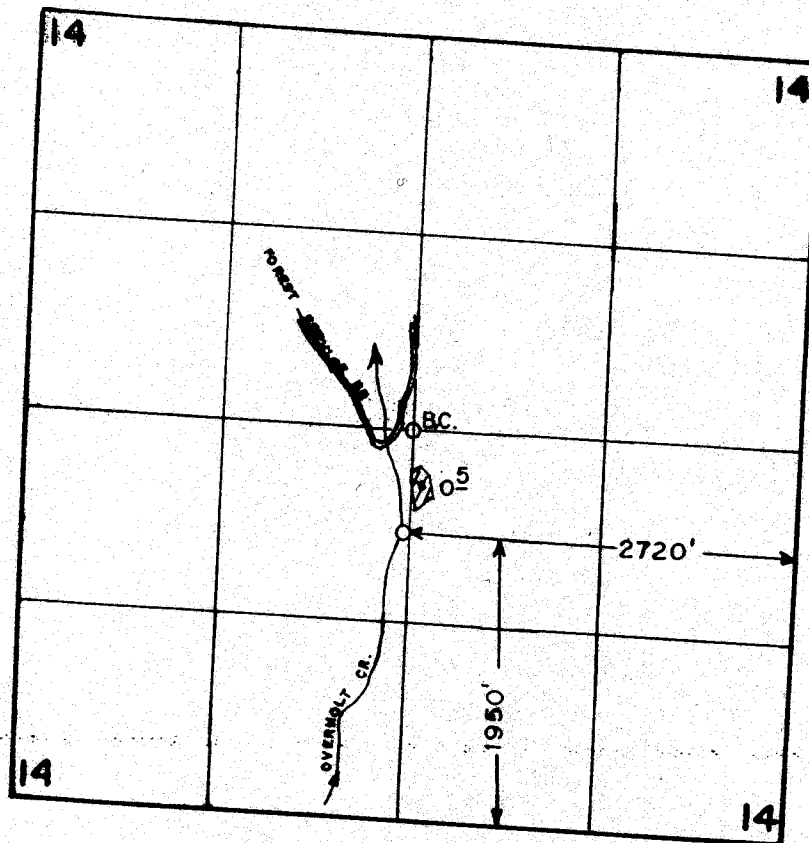

SCALE: 1"=1320'

FINAL PROOF SURVEY
UNDER

Application No. 61967... Permit No. 46285....
IN NAME OF

.....JOSEPH W. THOMPSON.....

Surveyed JUNE 20 1988.., by J. SALEH.....

PTS

7-20-89 CM