




T. 16 S., R. 1 W., W.M.

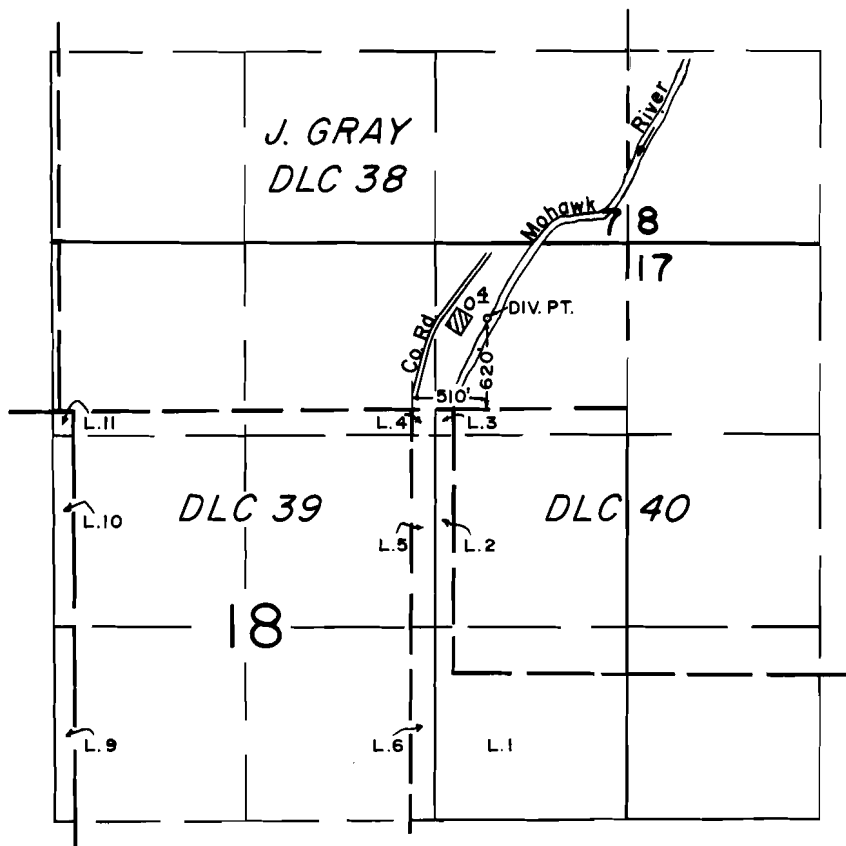

SCALE: 1" = 1320'

FINAL PROOF SURVEY
UNDER

Application No. 62364. Permit No. 46518.....
IN NAME OF

.....RUTH F. JACKSON.....

Surveyed OCT. 7.... 1986, by B. W. BISHOP...