


T.29S., R.14 W., W.M.

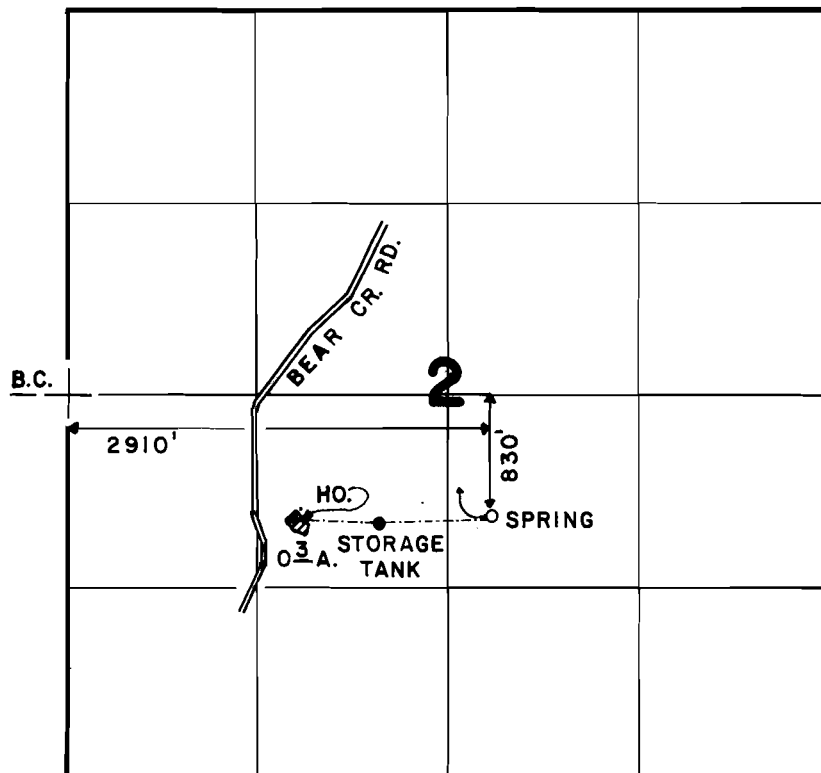

SCALE: 4" = 1 MILE

FINAL PROOF SURVEY
UNDER

Application No. **62604** Permit No. **46863**
IN NAME OF

ROBERT CARL GIBSON

Surveyed **OCT. 24** 19**85**, by **J. M. SCHMORDE**