


# T. 13 S., R. 10 W., W.M.

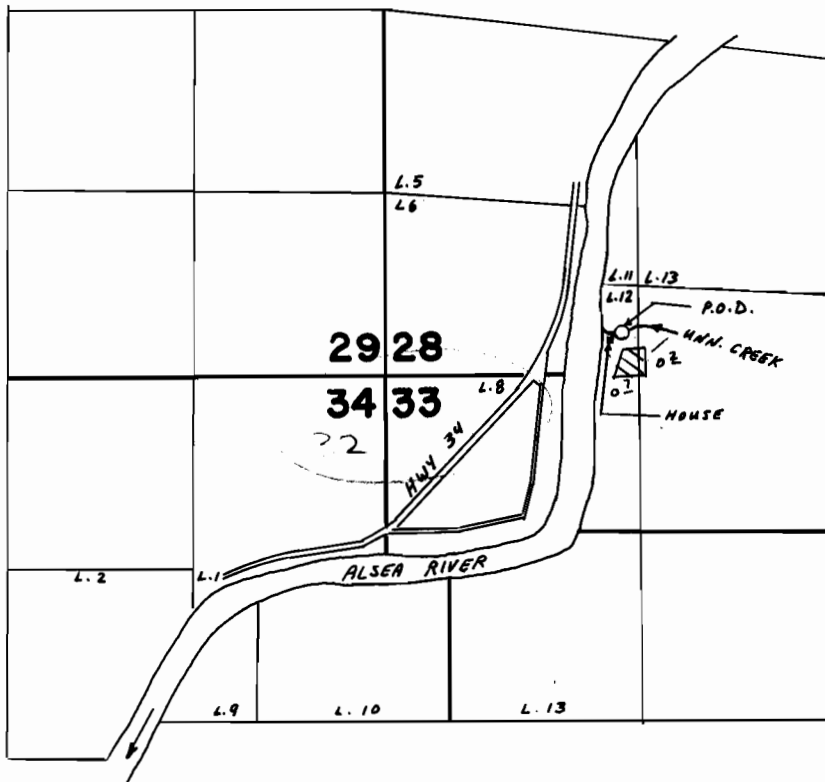

SCALE 1" = 1320'

P.O.D. : 300' N AND 1640' E FROM SE CORNER SEC. 28

## FINAL PROOF SURVEY UNDER

Application No. **63505** Permit No. **47304**

IN NAME OF

**JASON C. REYNOLDS**

Surveyed **JUL 26 1988**, by **Z. SALEH**

41041-172-214  
5-25-89 Z.f.S.