

**RECEIVED**

AUG 15 1983

WATER RESOURCES DEPT.  
SALEM, OREGON


**RECEIVED**

SEP 1 1983

WATER RESOURCES DEPT.  
SALEM, OREGON

*Detail of  
Holding Pond*

Application No. 65568 & R-65882  
Permit No. 47646 R 8804

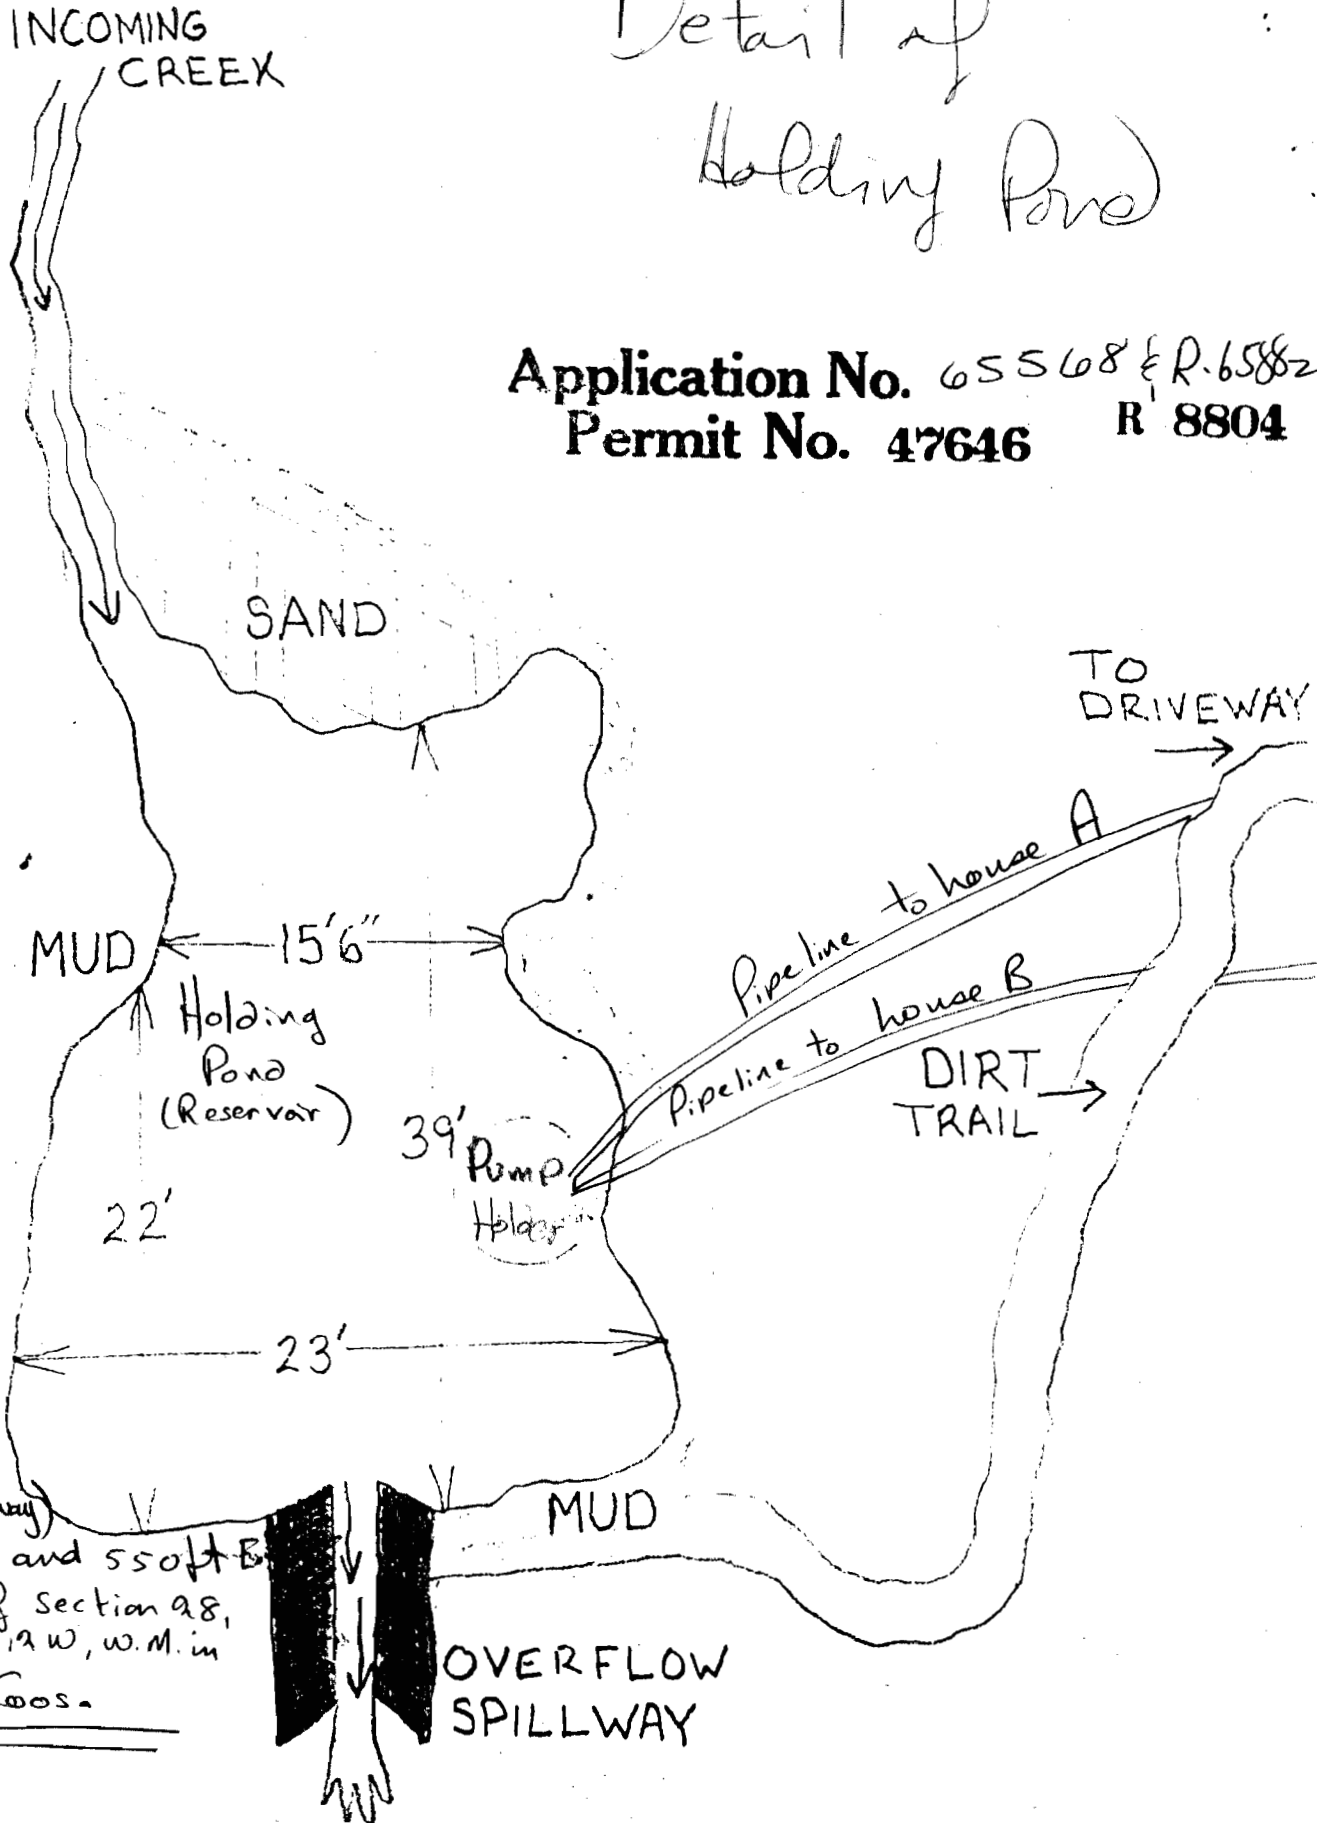

Point of diversion (spillway)  
located 1050 ft S. and 550 ft E.  
of NW corner of section 98,  
township 25 S, R 12 W, W.M. in  
the County of Coos.

RECEIVED

AUG 15 1983

WATER RESOURCES DEPT.  
SALEM, OREGON


RECEIVED

SEP 1 1983

WATER RESOURCES DEPT.  
SALEM, OREGON

Detail of  
Holding Pond

Application No. 65568 & R. 65882  
Permit No. 47646 R 8804

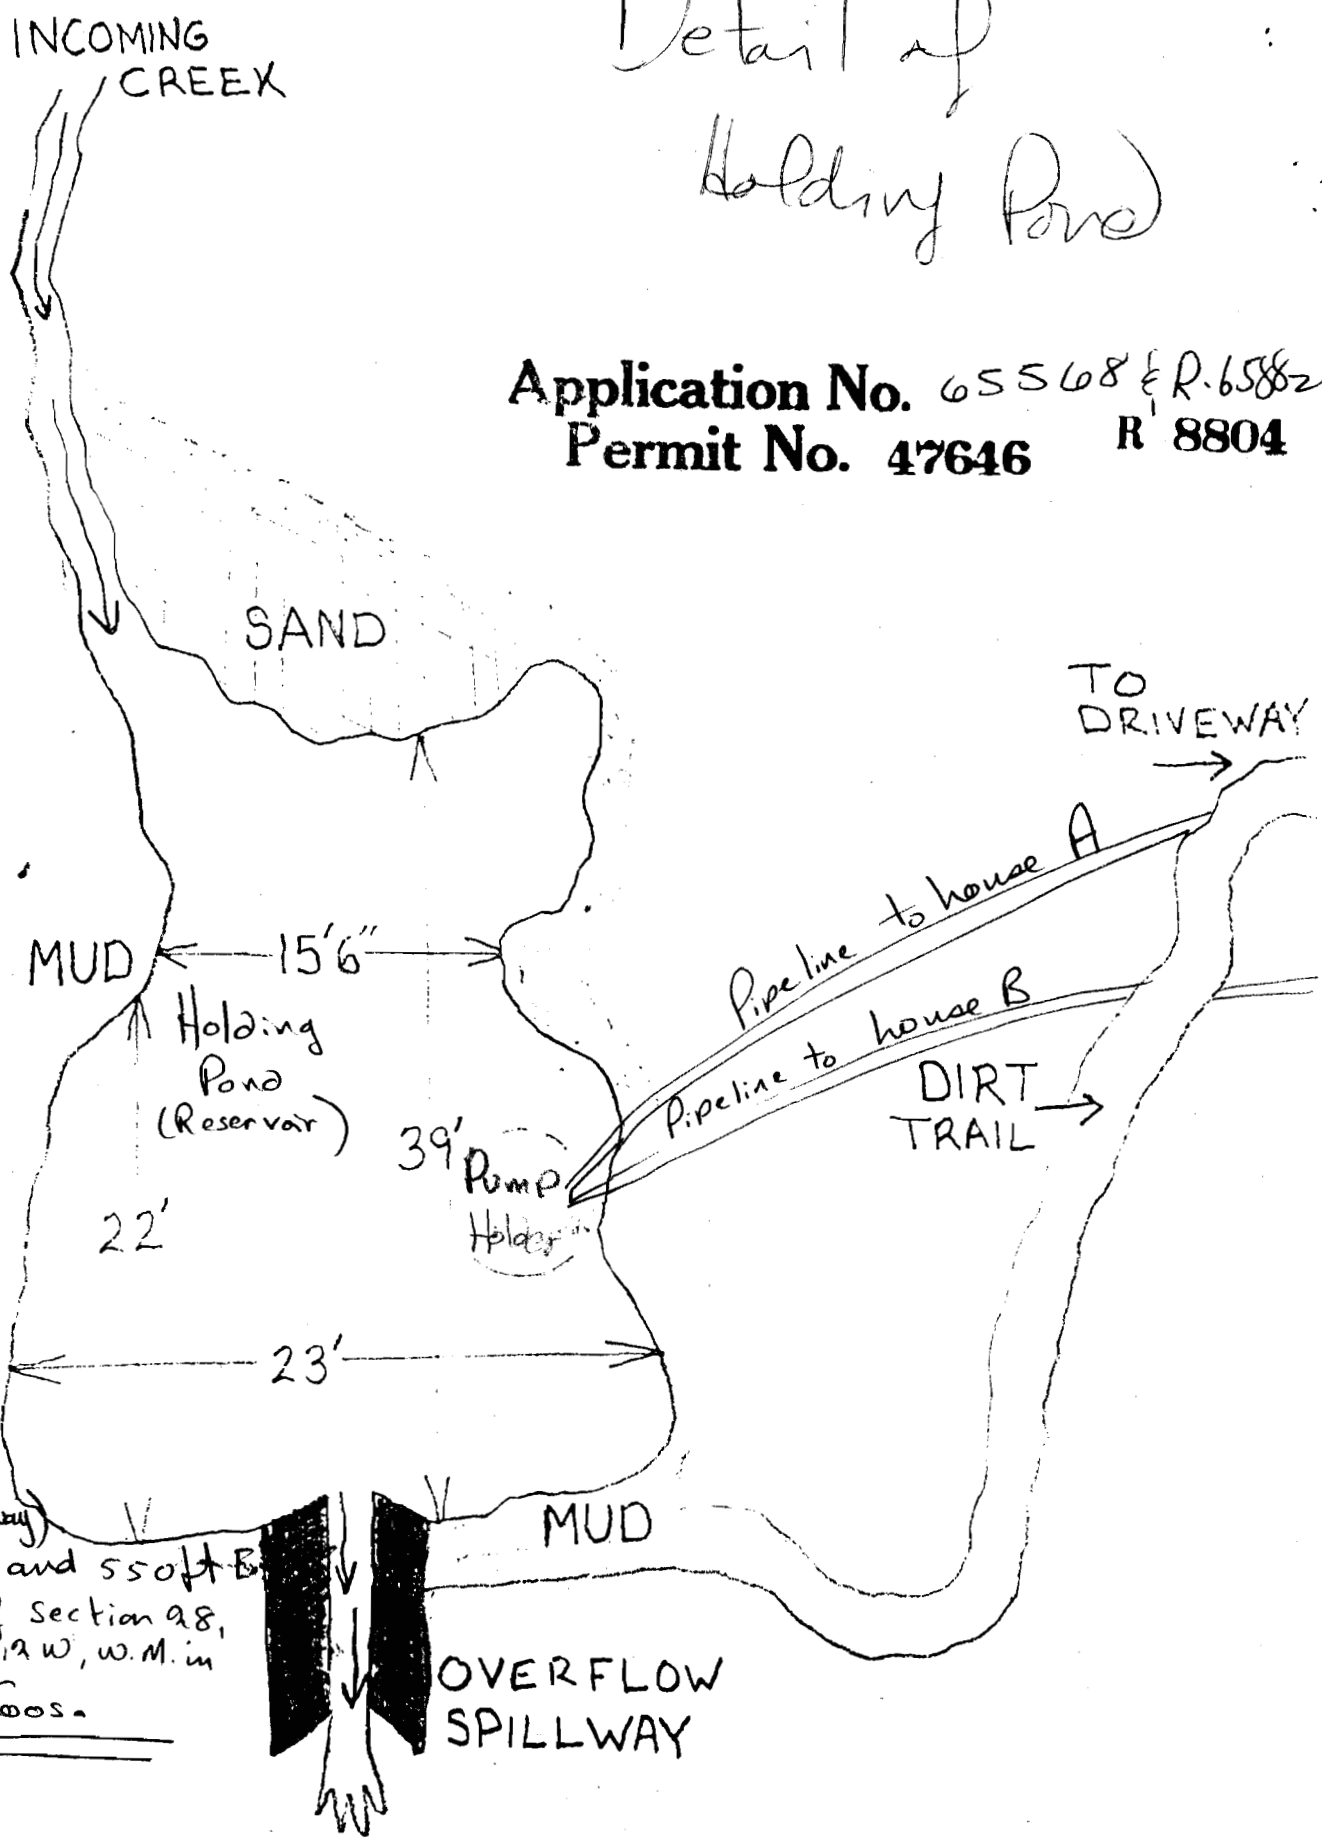

Point of diversion (spillway)  
located 1050 ft S. and 550 ft E.  
of NW corner of section 28,  
Township 25 S, R. 12 W, W.M. in  
the County of Coos.