


T. 38 & 39 S., R. 3 W., W. M.

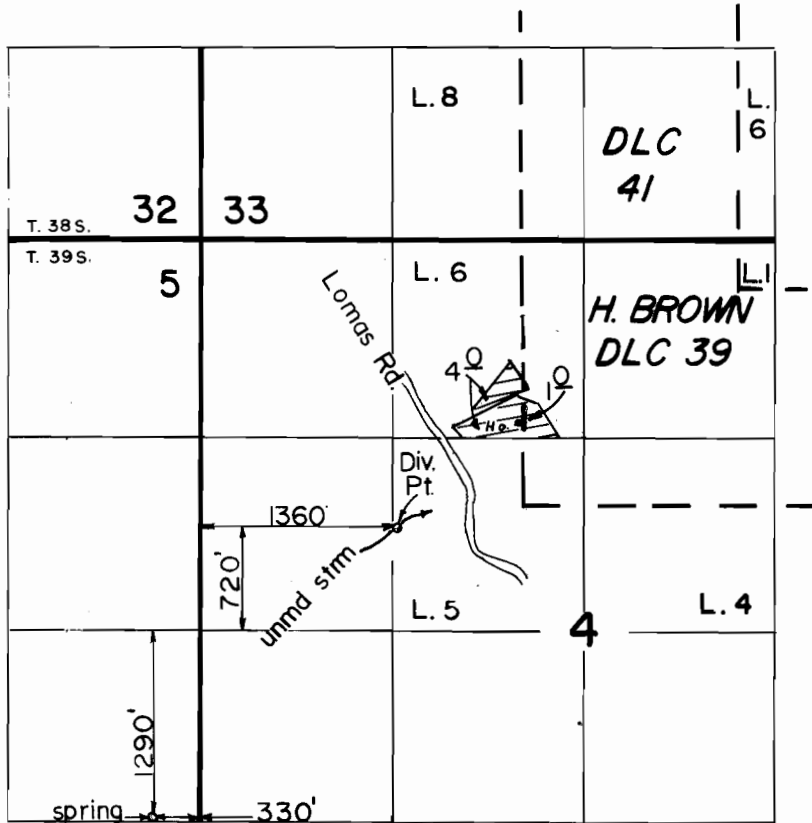

Scale: 1" = 1320'

FINAL PROOF SURVEY UNDER

Application No. ~~65820~~ Permit No. ~~48022~~..
IN NAME OF

.....LINDA STEWART.....

Surveyed FEB. 8, 1988, by B. S. JAMES.....