



T.10S., R.42E., W.M.

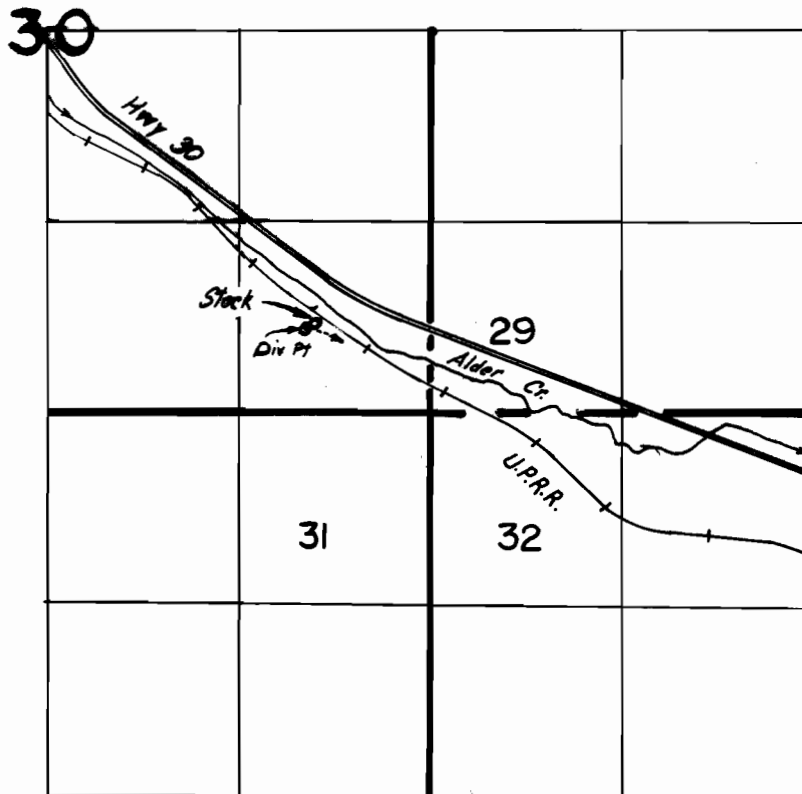

The location of the div. pt. is 560' N. &
850' W. from SE cor. sec. 30.

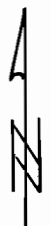

Scale: 1" = 1320'

FINAL PROOF SURVEY UNDER

Application No. 66721 Permit No. 48237....
IN NAME OF

USDI - BLM

Surveyed 6-3-1988, by Vern Church...