


FINAL PROOF MAP

Located in the S.W. 1/4 of Section 26 and the N.W. 1/4 Section 35
Township 2 South, Range 5 West of the Willamette Meridian
Yamhill County, Oregon

This map is prepared solely for the
purpose of locating the water right
and is not to be used for any other
purpose.

APPLICATION NO. 89235

PERMIT NO. 50136

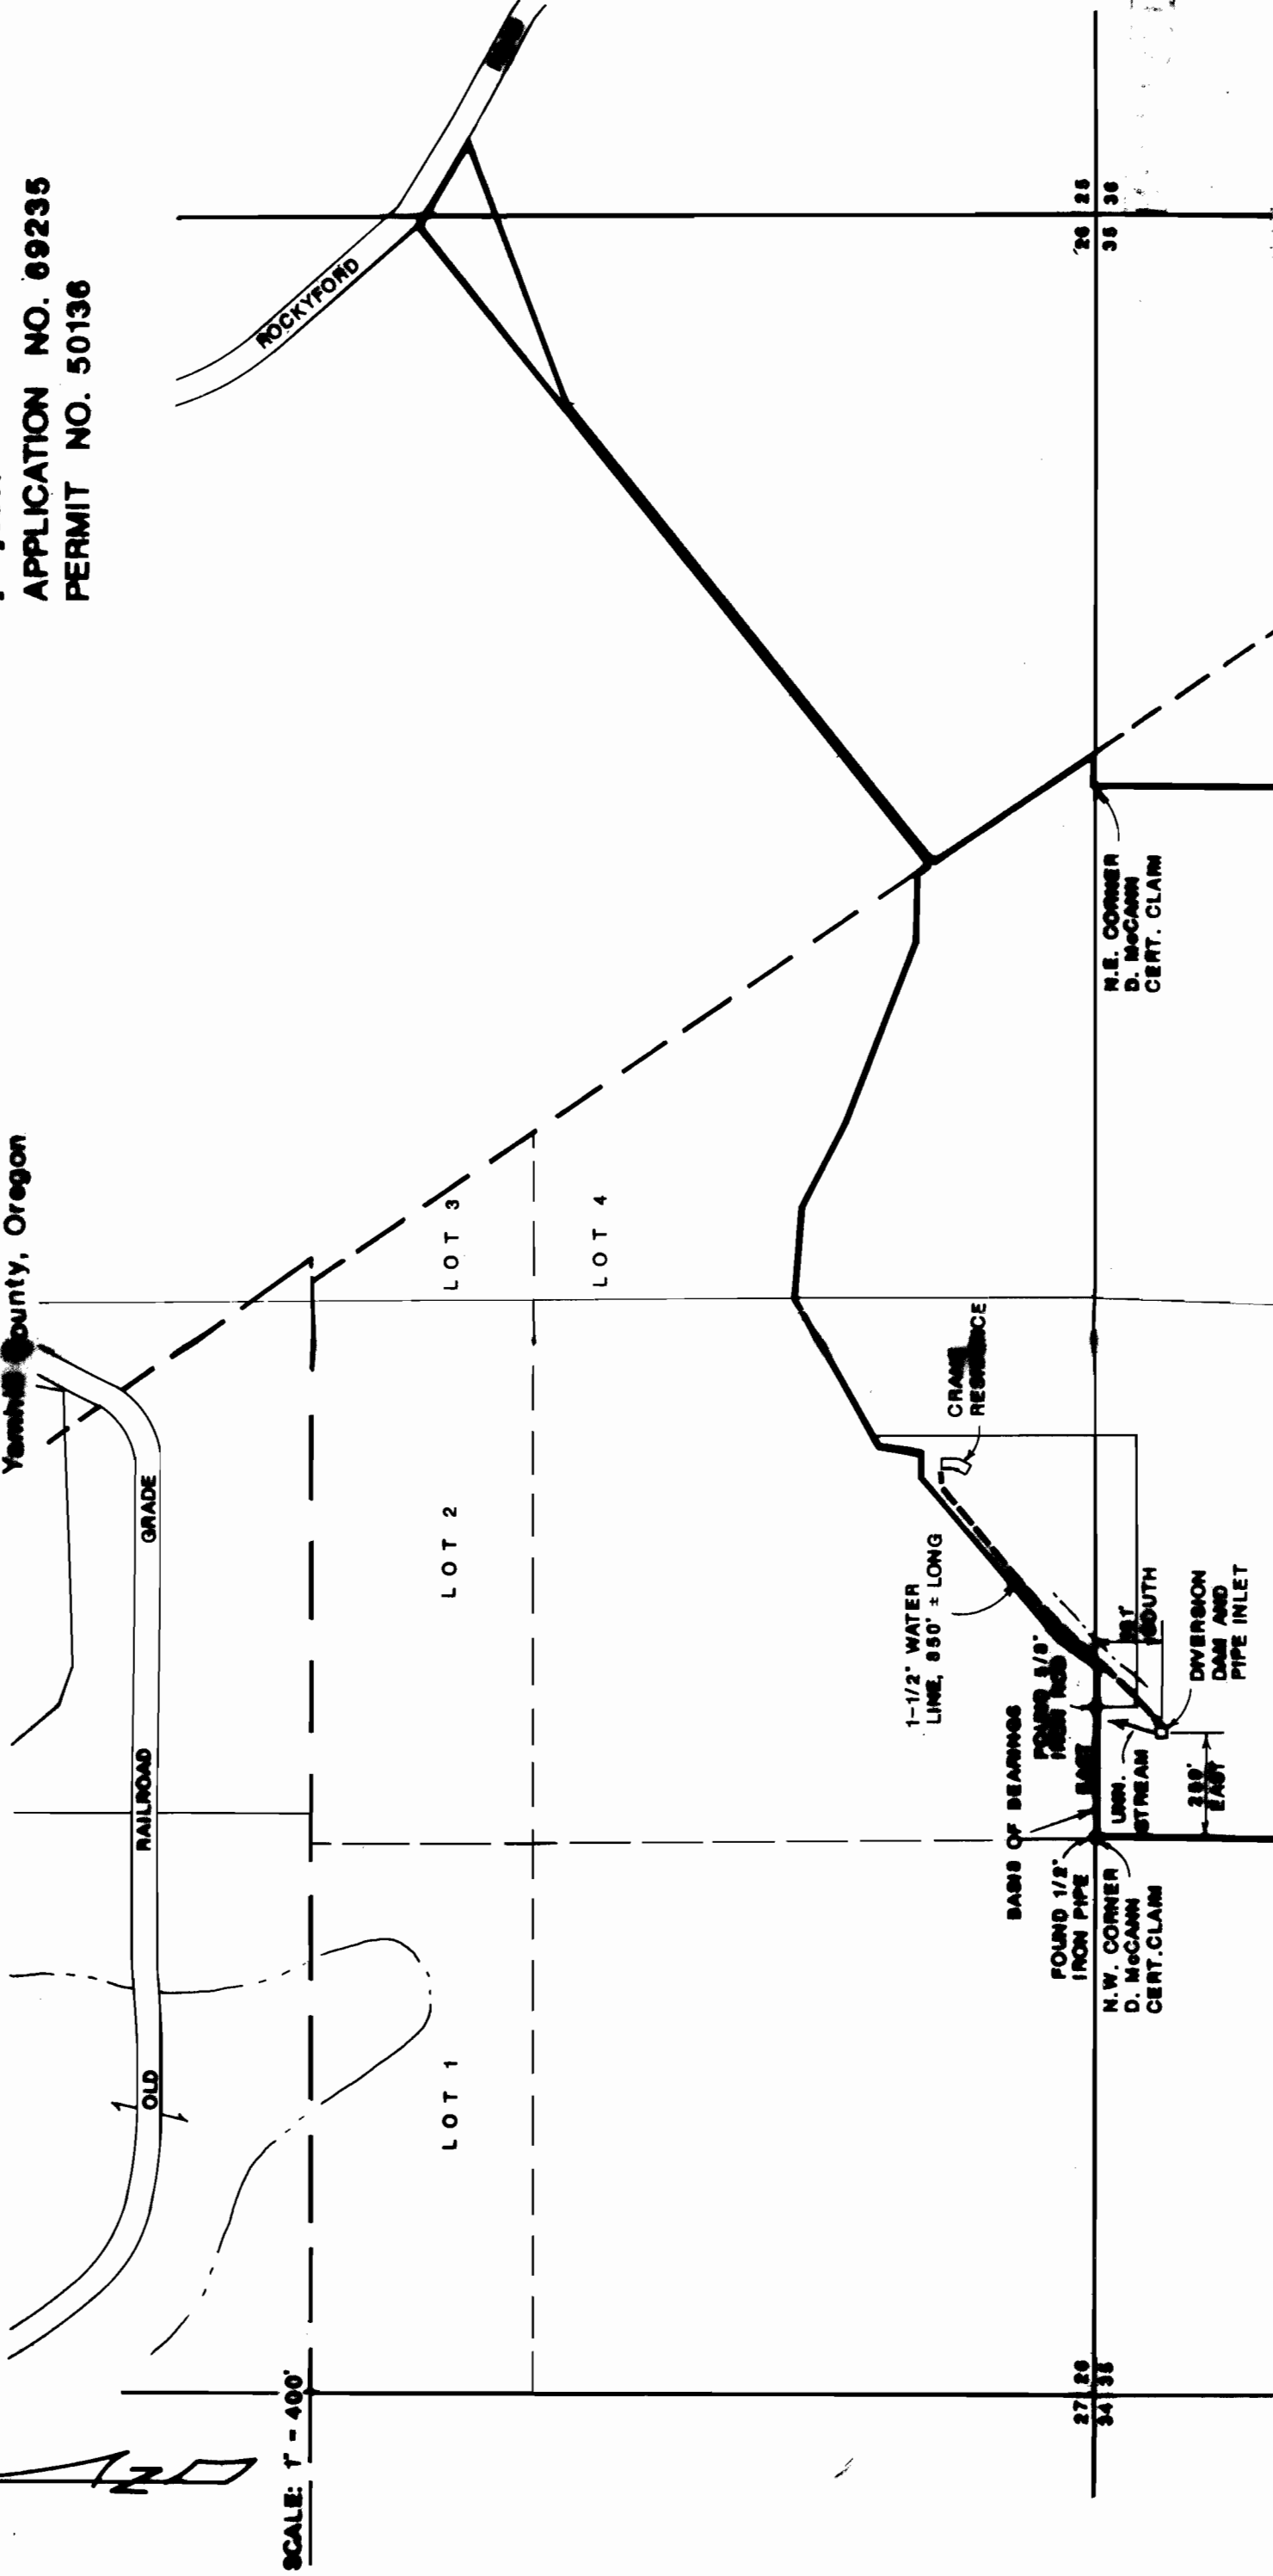

Prepared For:

Robert L. and Cordelia E. Crane
19100 N. W. Crane Lane
Yamhill, Oregon 97148

Phone: (503) 662-3841

Prepared By:

Leonard A. Rydell, W.R.E.
601 Pinehurst Drive
Newberg, Oregon 97132

Phone: (503) 538-5700

