


# T.13S., R.17E., W.M.

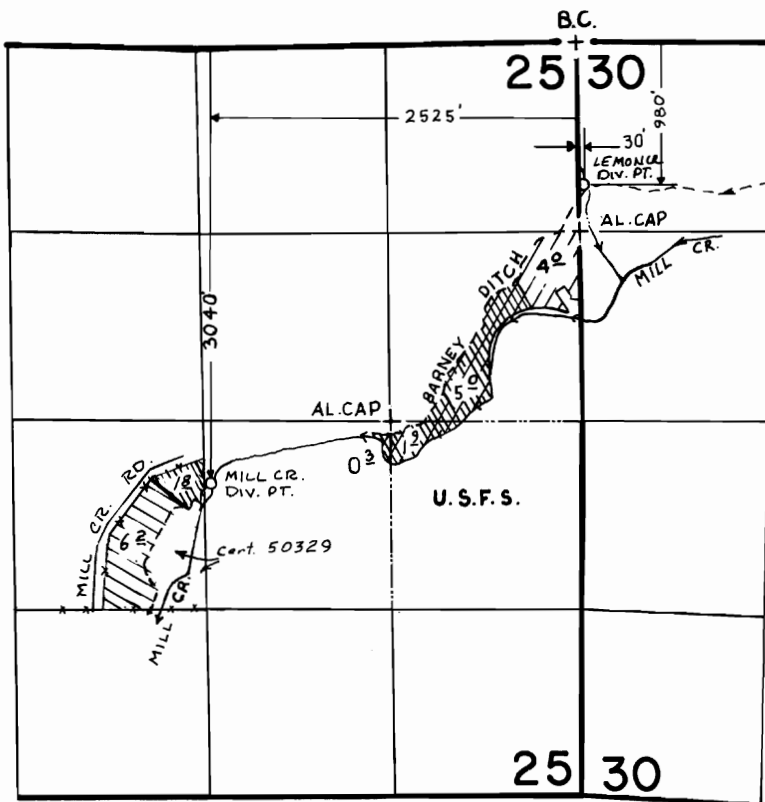


SCALE: 1" = 1320'

## FINAL PROOF SURVEY

UNDER

TRANSFER NO. 4777  MILL CR. PRIM. 1883

61719 46055  MILL CR. PRIM. 1981

Application No. 61720..... Permit No. 46056  LEMON CR. SUPP. 1981

IN NAME OF

**BLANCHE HEREFORD**

Surveyed AUG. 30. 1984., by LESLIE OLSON.....  
MAY 30 1986

Rev. 7/86

PTS 11-1984 A, 1986 A

MJM

REV. 4/87