


T. 1 S. R. 4 W. W. M.

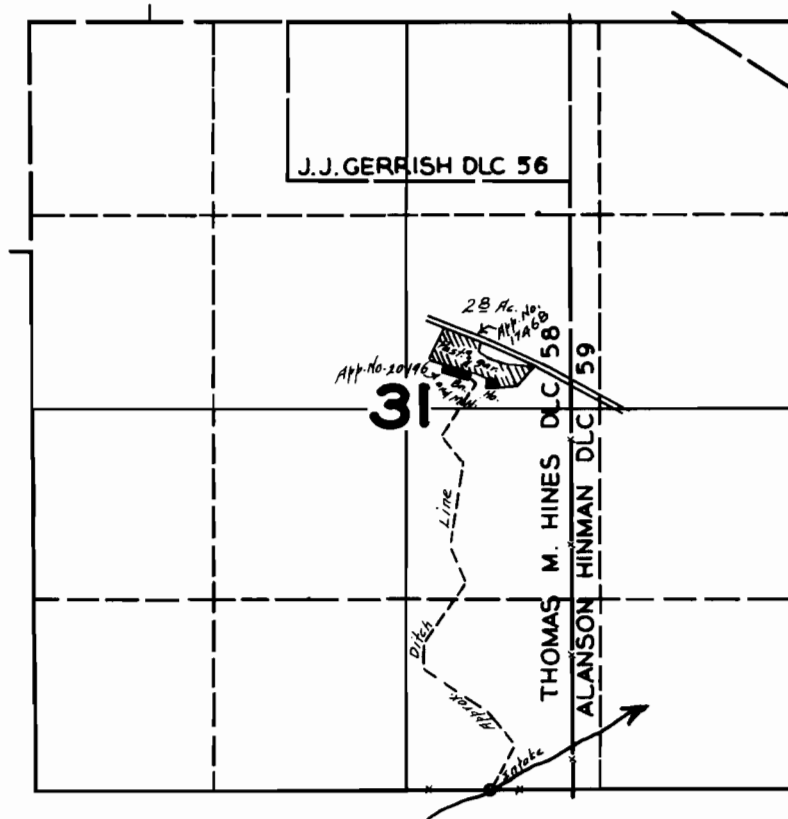

FINAL PROOF SURVEY

UNDER

Application No. 20196 17468 Permit No. 15748 13179

IN NAME OF

R. F. CLARKE

Surveyed JULY 24 1944, by [Signature]