


T.14S., R.15E., W.M.

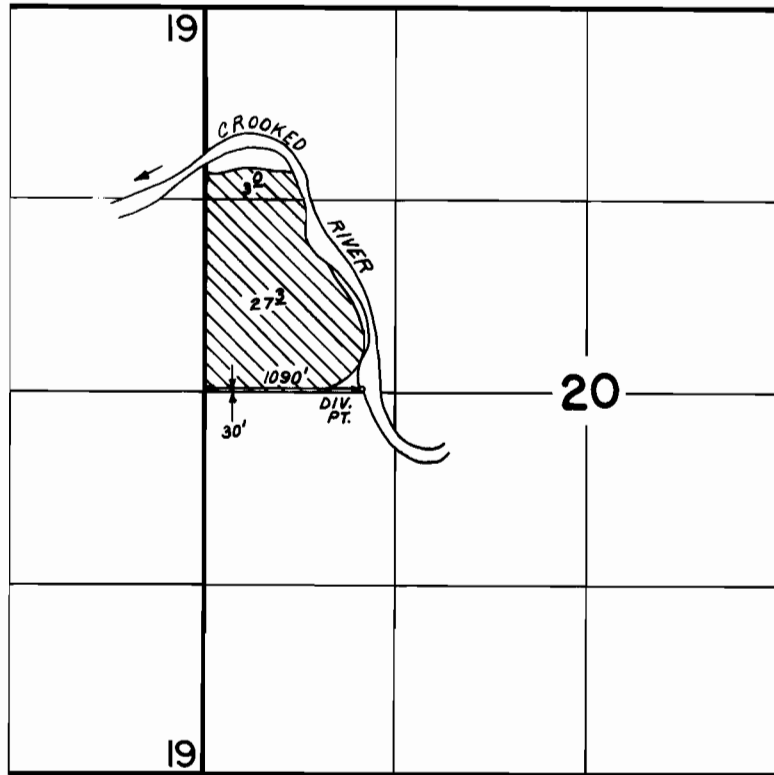

SCALE: 1" = 1320'

FINAL PROOF SURVEY
UNDER

Application No. 64409... Permit No. 47266.....
IN NAME OF

PETER B. KING.....

Surveyed FEB. 27, 1985, by LESLIE OLSON..