


6207 RECEIVED

MAR 6 1989
WATER RESOURCES DEPT.
SALEM, OREGON

T. 2 N. R. 14 E. W. M. WASCO COUNTY, OREGON



SCALE: 4" = 1 MILE

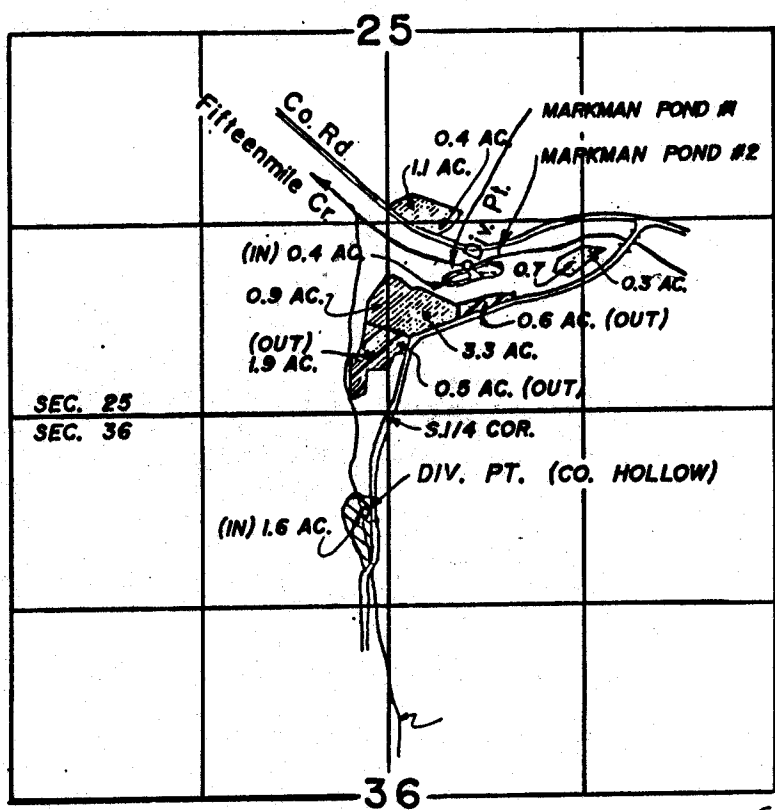

DIV. PT. FIFTEENMILE CREEK - 1020 ft N and 800 ft E from S 1/4 Cor Sec 25
COMPANY HOLLOW - 700 ft. South and 240 ft. West from S 1/4 Cor. Sec. 25

TRANSFER OF CERTIFICATE

APPLICATION No. 33956

PERMIT No. 26769

IN THE NAME OF:
MARVIN L. MARKMAN

FEBRUARY 20, 1989.

BY:
TENNESON ENGINEERING CORP.
409 LINCOLN STREET
THE DALLES, OREGON. 97058.
PH. (503) 296-9177

NOTES:

MAP PREPARED FROM PRIOR SURVEY,
APRIL 8, 1963, BY LARRY JEBOUSEK.


"THIS MAP IDENTIFIES THE LOCATION OF THE
WATER RIGHT ONLY AND IS NOT INTENDED
TO PROVIDE DIMENSIONS OR LOCATE
PROPERTY OWNERSHIP LINES."



T-6207

From map

T. 2 N. R. 14 E. W.M.

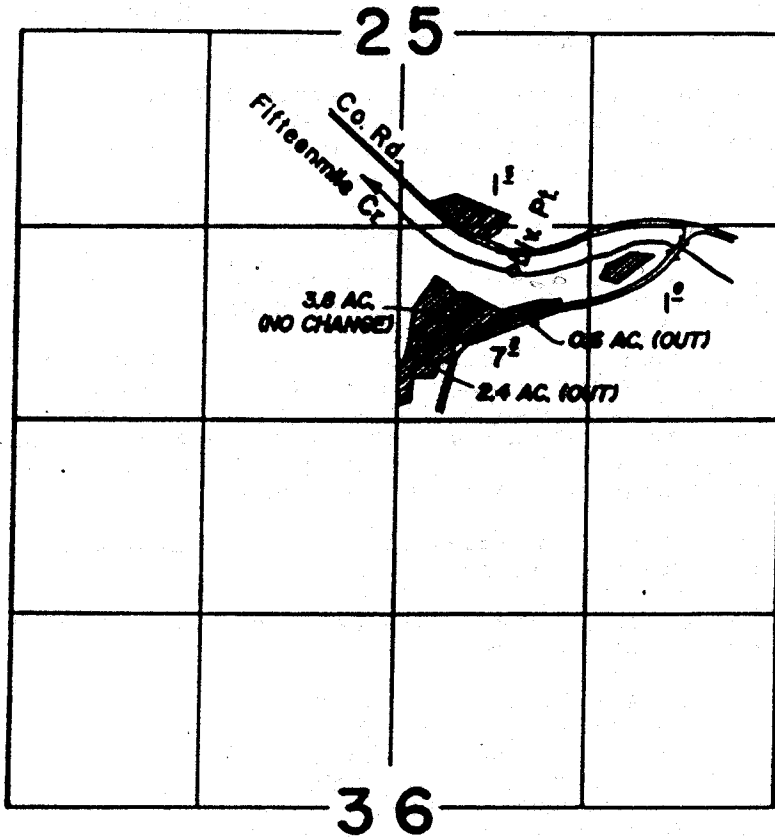

FOR TRANSFER OF WATER RIGHT EXISTING LOCATION TRANSFERRED FROM

**FINAL PROOF SURVEY
UNDER**



Application No. 33956... Permit No. 26769...
IN NAME OF

MARVIN L. MARKMAN

Surveyed April 8, 1963, by

Larry J. Joubert

NOTE:
MAP PREPARED FROM
FINAL PROOF SURVEY
BY LARRY JEBOUSEK,
APRIL 8, 1963.