

R-9401

RECEIVED 62545Form OR-010-7300-2
4/83UNITED STATES
DEPARTMENT OF THE INTERIOR
BUREAU OF LAND MANAGEMENTSEP 2 1983
WATER RESOURCES DEPT.
SALEM, OREGON

Section

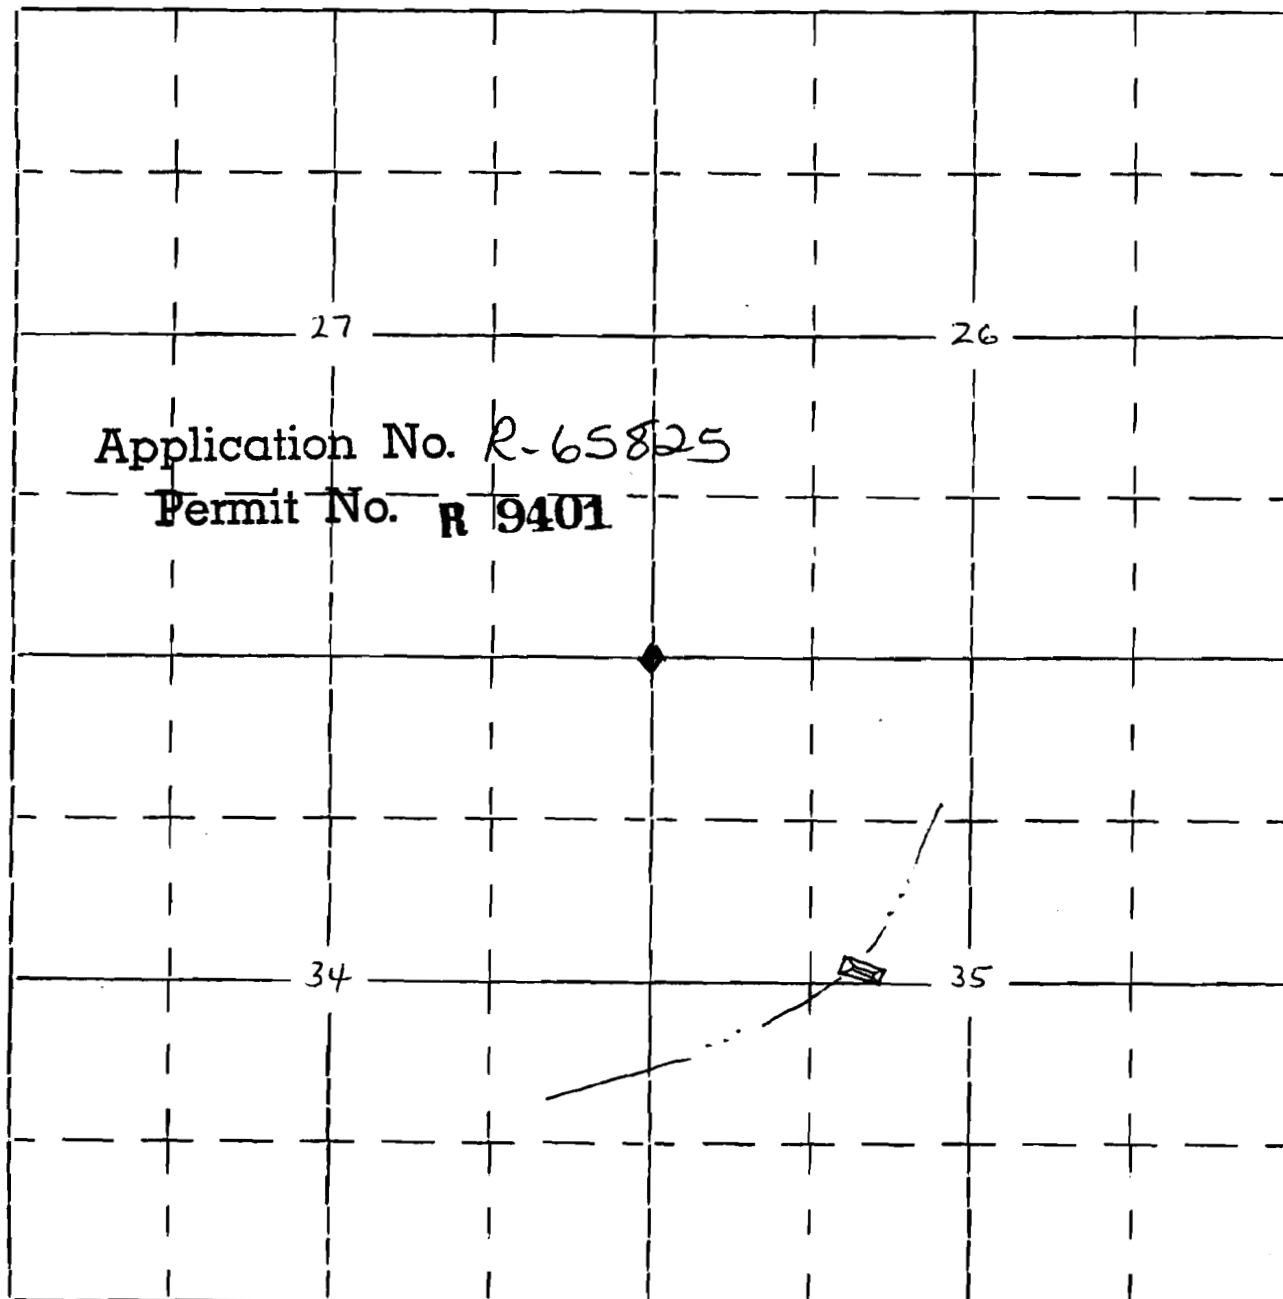
Township 39 S

Appl. No. _____

26, 27, 34 & 35Range 14 E

Permit No. _____

Will. Mer.

Application No. R-65825Permit No. R 9401

Project is located 1,250' south and 1,687' east of corner common
to sections 26, 27, 34 & 35.