

R-9403
62547

RECEIVED

Form OR-010-7300-2
4/83

UNITED STATES
DEPARTMENT OF THE INTERIOR
BUREAU OF LAND MANAGEMENT

SEP 2 1983
WATER RESOURCES DEPT.
SALEM, OREGON

Section

Township 40 S.


Appl. No. _____

21, 22, 27 & 28

Range 14 E.

Permit No. _____

Will. Mer.

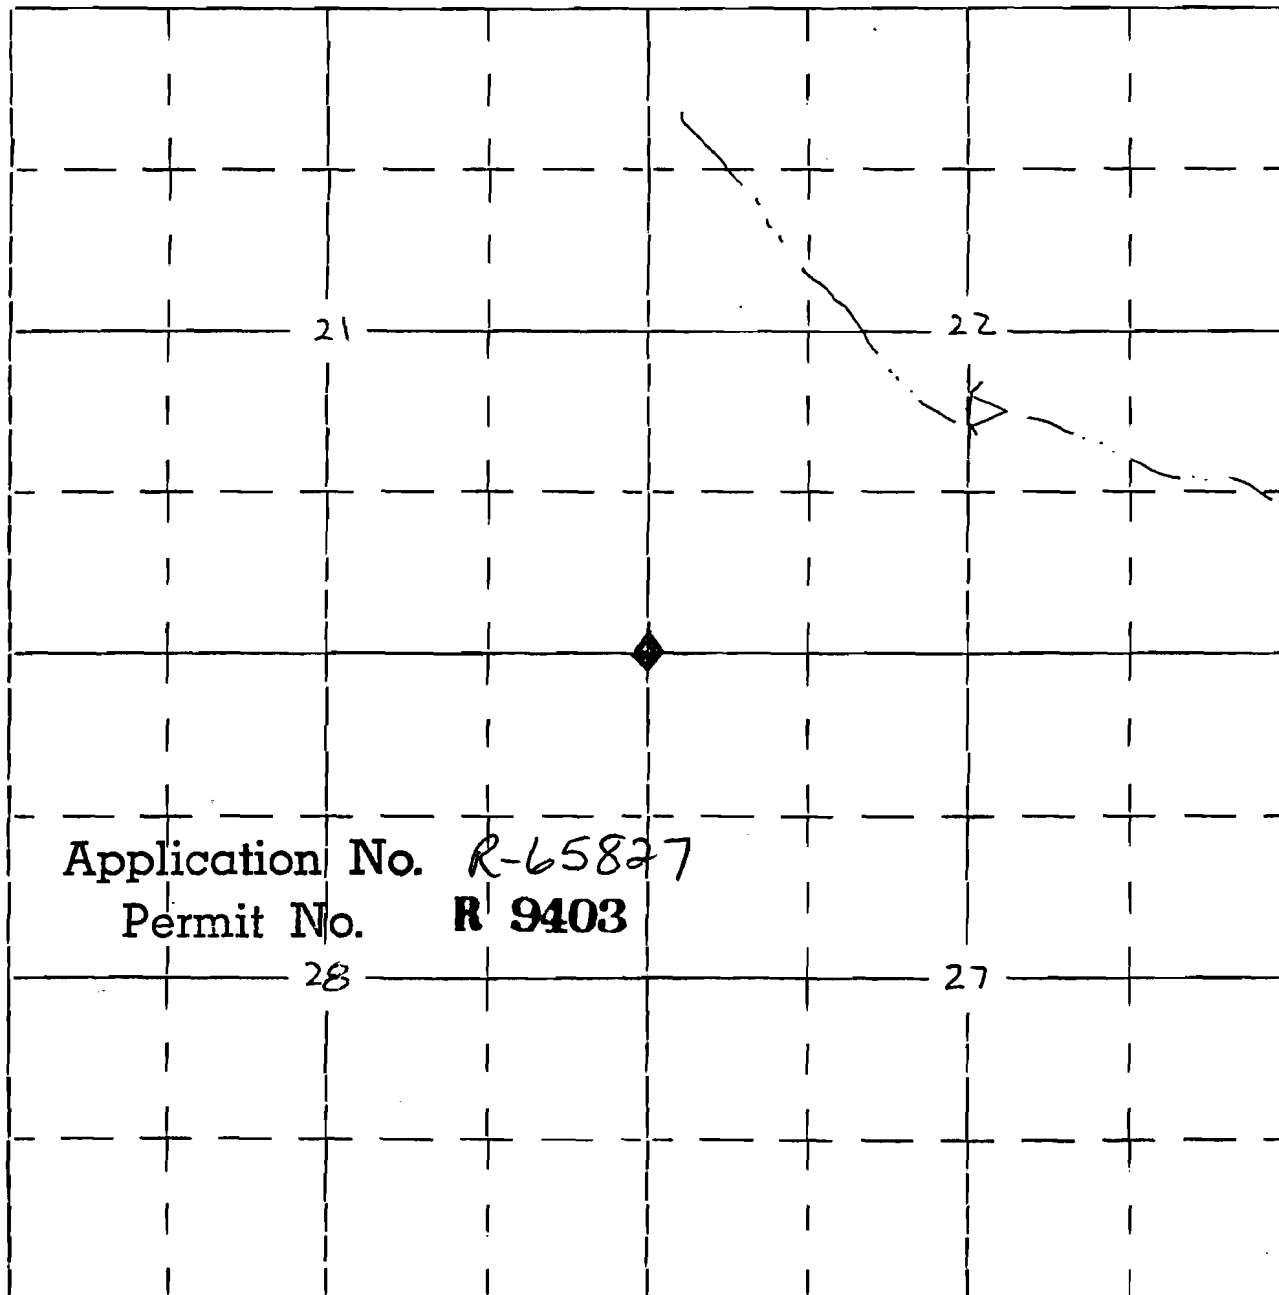

Project is located north 1,986' and 2,650' west of corner
Common to sections 21, 22, 27 & 28.