

R-9405
62549

RECEIVED

SEP 2 1983

WATER RESOURCES DEPT.
SALEM, OREGON

Form OR-010-7300-2
4/83

UNITED STATES
DEPARTMENT OF THE INTERIOR
BUREAU OF LAND MANAGEMENT

Section

3, 4, 9 & 10


Township 40 S.

Range 14 E.

Will. Mer.

Appl. No. R-65829

Permit No. R 9405

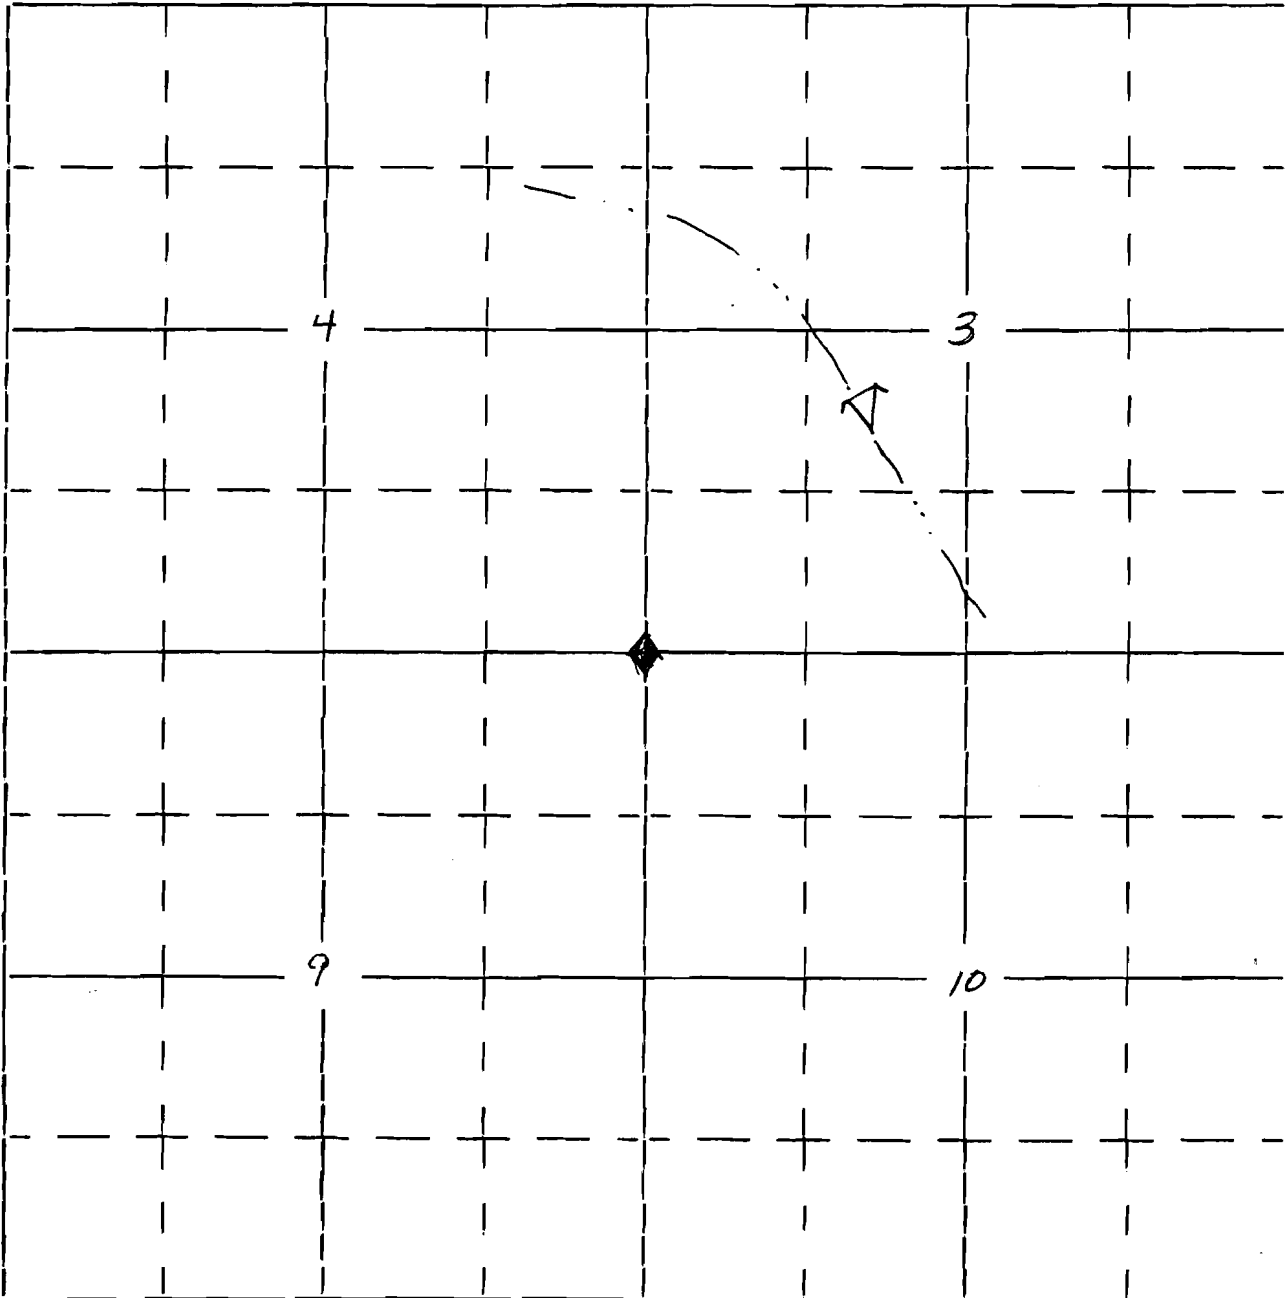

Project is located 2,187' North and 1,875' east of corner
common to sections 3, 4, 9 & 10.