

R-9406
62550

RECEIVED

SEP 2 1983
WATER RESOURCES DEPT.
SALEM, OREGON

Form OR-010-7300-2
4/83

UNITED STATES
DEPARTMENT OF THE INTERIOR
BUREAU OF LAND MANAGEMENT

Section

Township 40 S.


Appl. No. R-65830

14, 15, 22 & 23

Range 14 E.

Permit No. R 9406

Will. Mer.

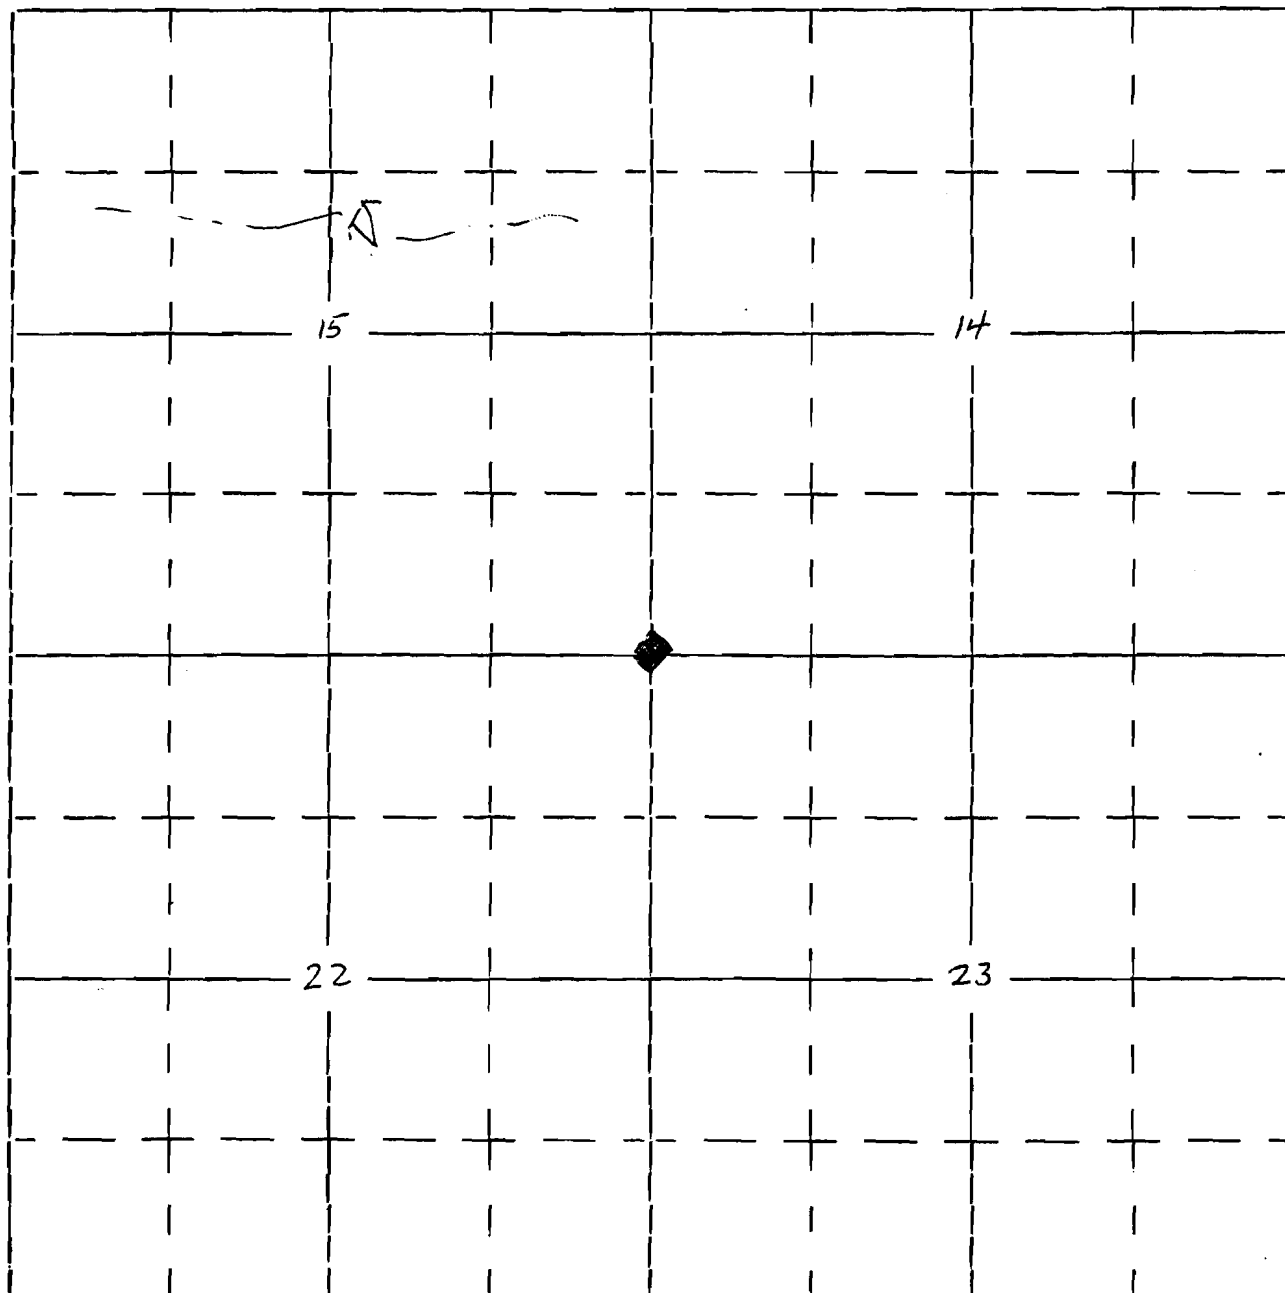

Project is located 3,343' north and 2,249' west of corner
Common to sections 14, 15, 22 & 23.