

RECEIVED R-9407
62551

SEP 2 1983

WATER RESOURCES DEPT.
SALEM, OREGON

Form OR-010-7300-2
4/83

UNITED STATES
DEPARTMENT OF THE INTERIOR
BUREAU OF LAND MANAGEMENT

Section

Township 40 S.


Appl. No. R-65831

29, 30, 31 & 32

Range 15 E.

Permit No. R 9407

Will. Mer.

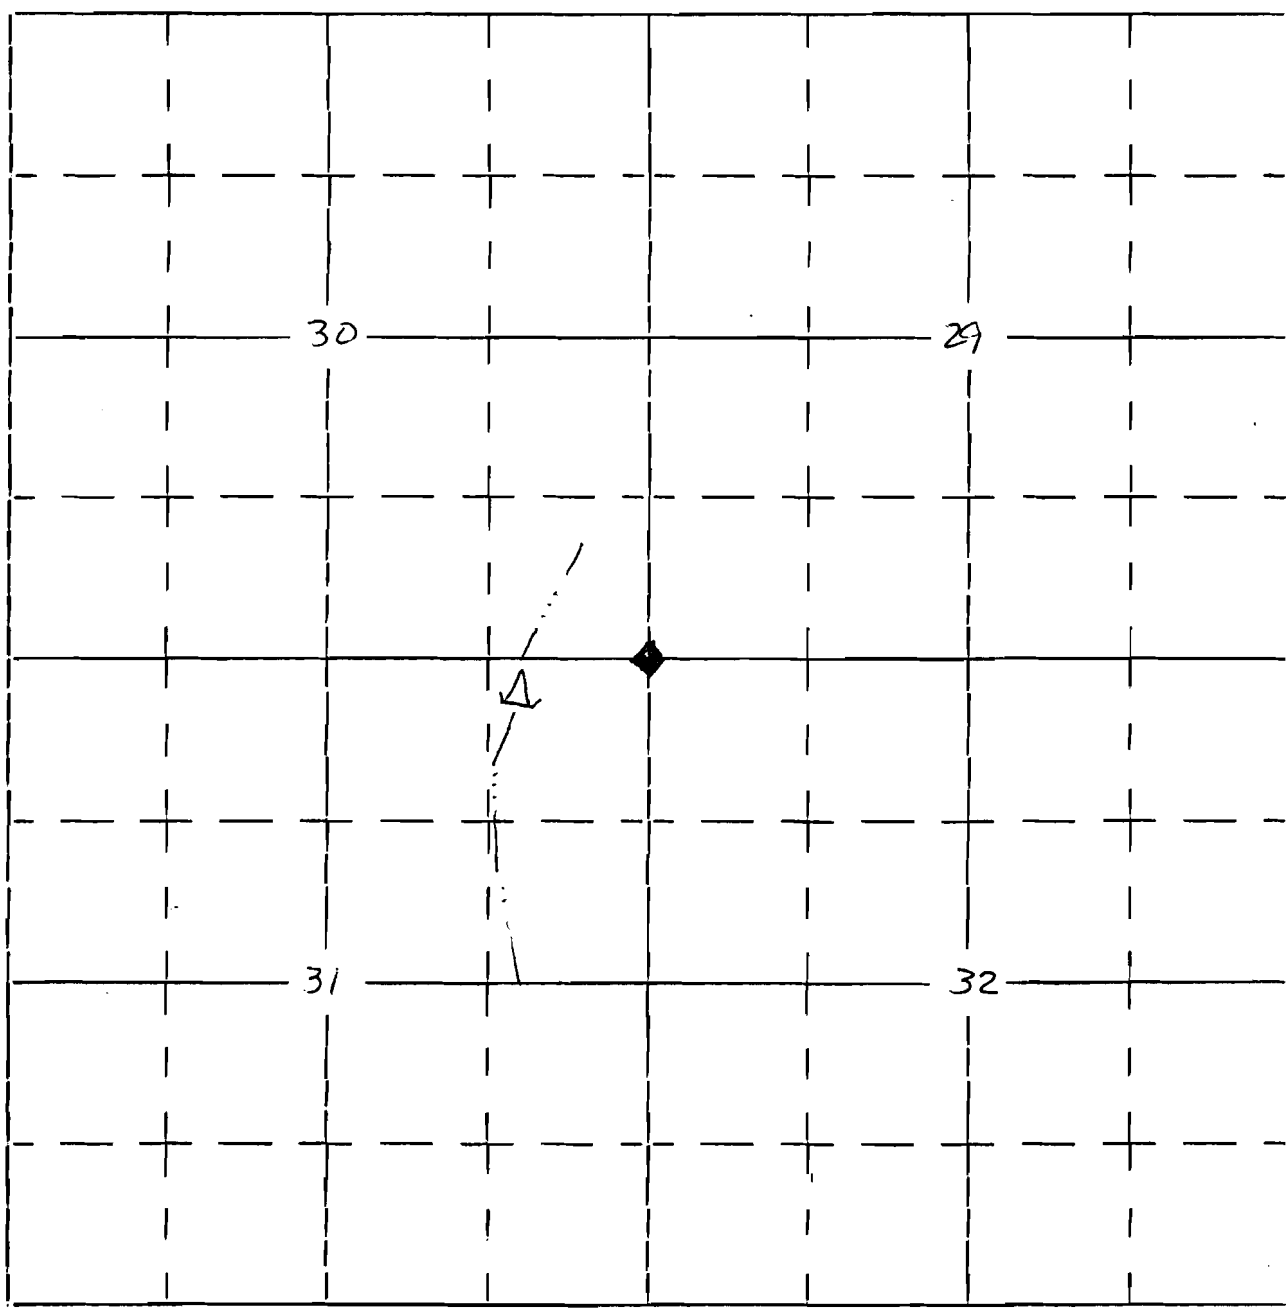

Project is located 125' south and 1,156' east of corner common to sections 29, 30, 31 & 32.