

R-9408
RECEIVED 62552

SEP 2 1983
WATER RESOURCES DEPT.
SALEM, OREGON

Form OR-010-7300-2
4/83

UNITED STATES
DEPARTMENT OF THE INTERIOR
BUREAU OF LAND MANAGEMENT

Section

36, 1, 31, 6


Township 40 3 41 S.

Range 14 1/2 E 15 E.

Appl. No. R-65832

Permit No. R 9408

Will. Mer.

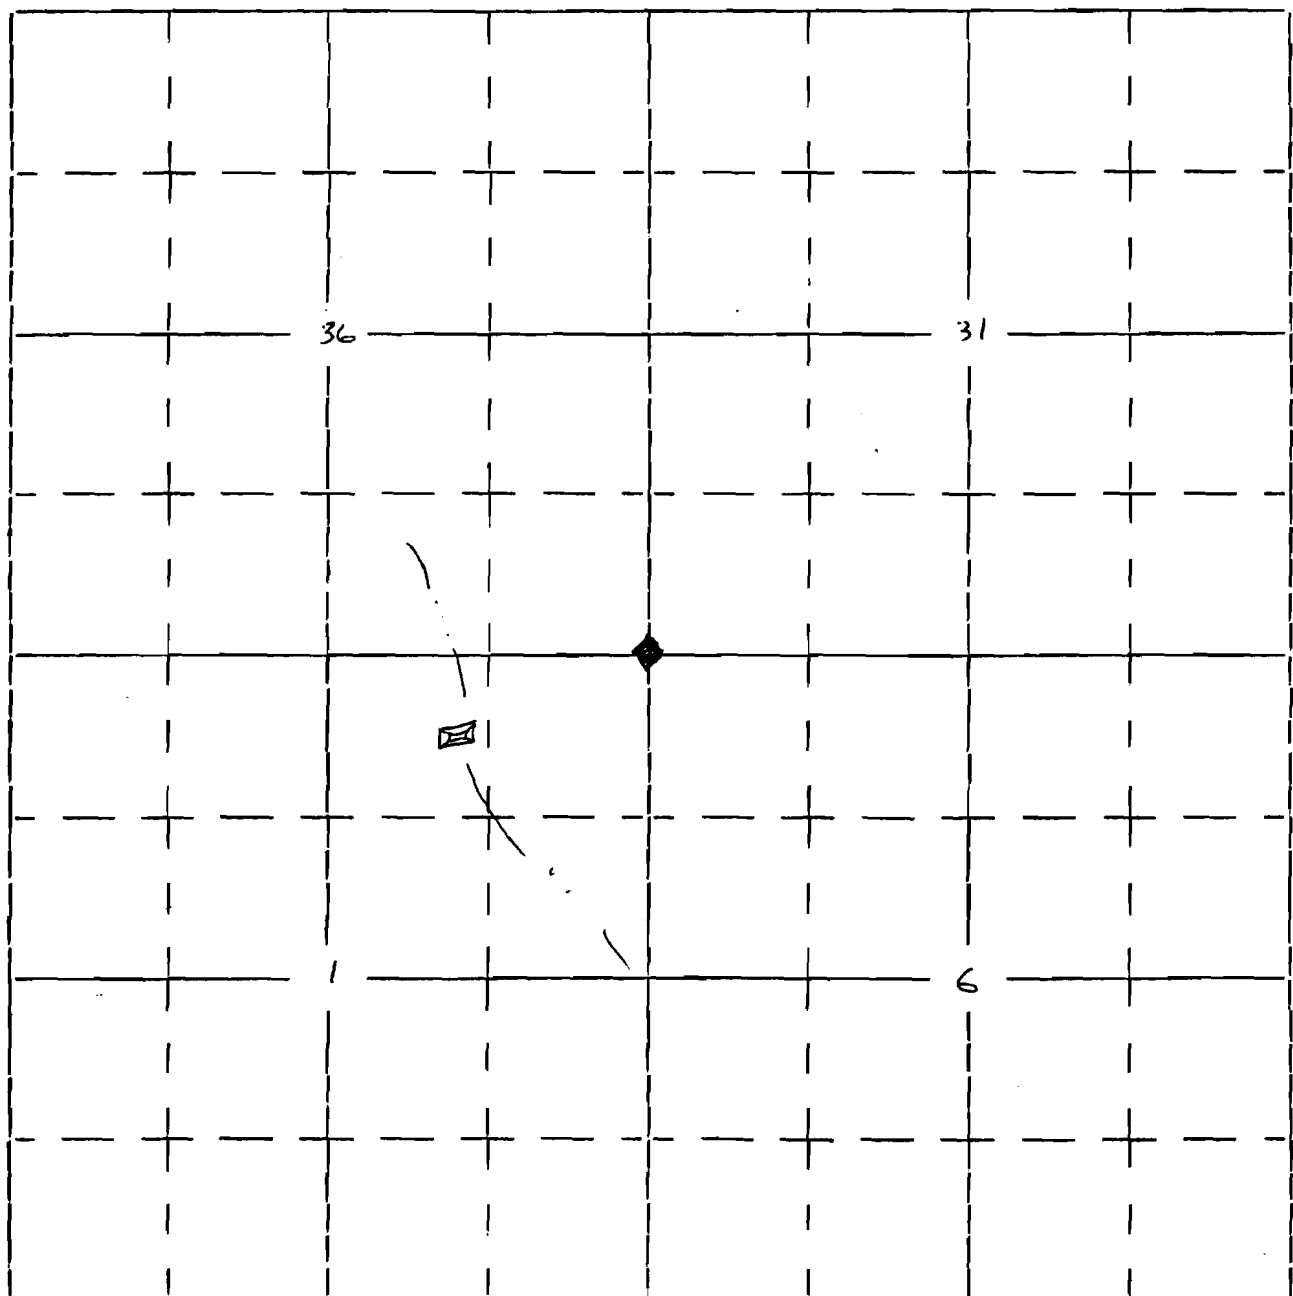

Project is located 1,468' west and 656' south of corner common to sections 36, 1, 31, 6.