

R-9409
62553

RECEIVED

Form OR-010-7300-2
4/83

UNITED STATES
DEPARTMENT OF THE INTERIOR
BUREAU OF LAND MANAGEMENT

SEP 2 1983
WATER RESOURCES DEPT.
SALEM, OREGON

Section

Township 40 S.


Appl. No. R-65833

12, 13 & 7, 18

Range 14 1/2 & 15 E.

Permit No. R 9409

Will. Mer.

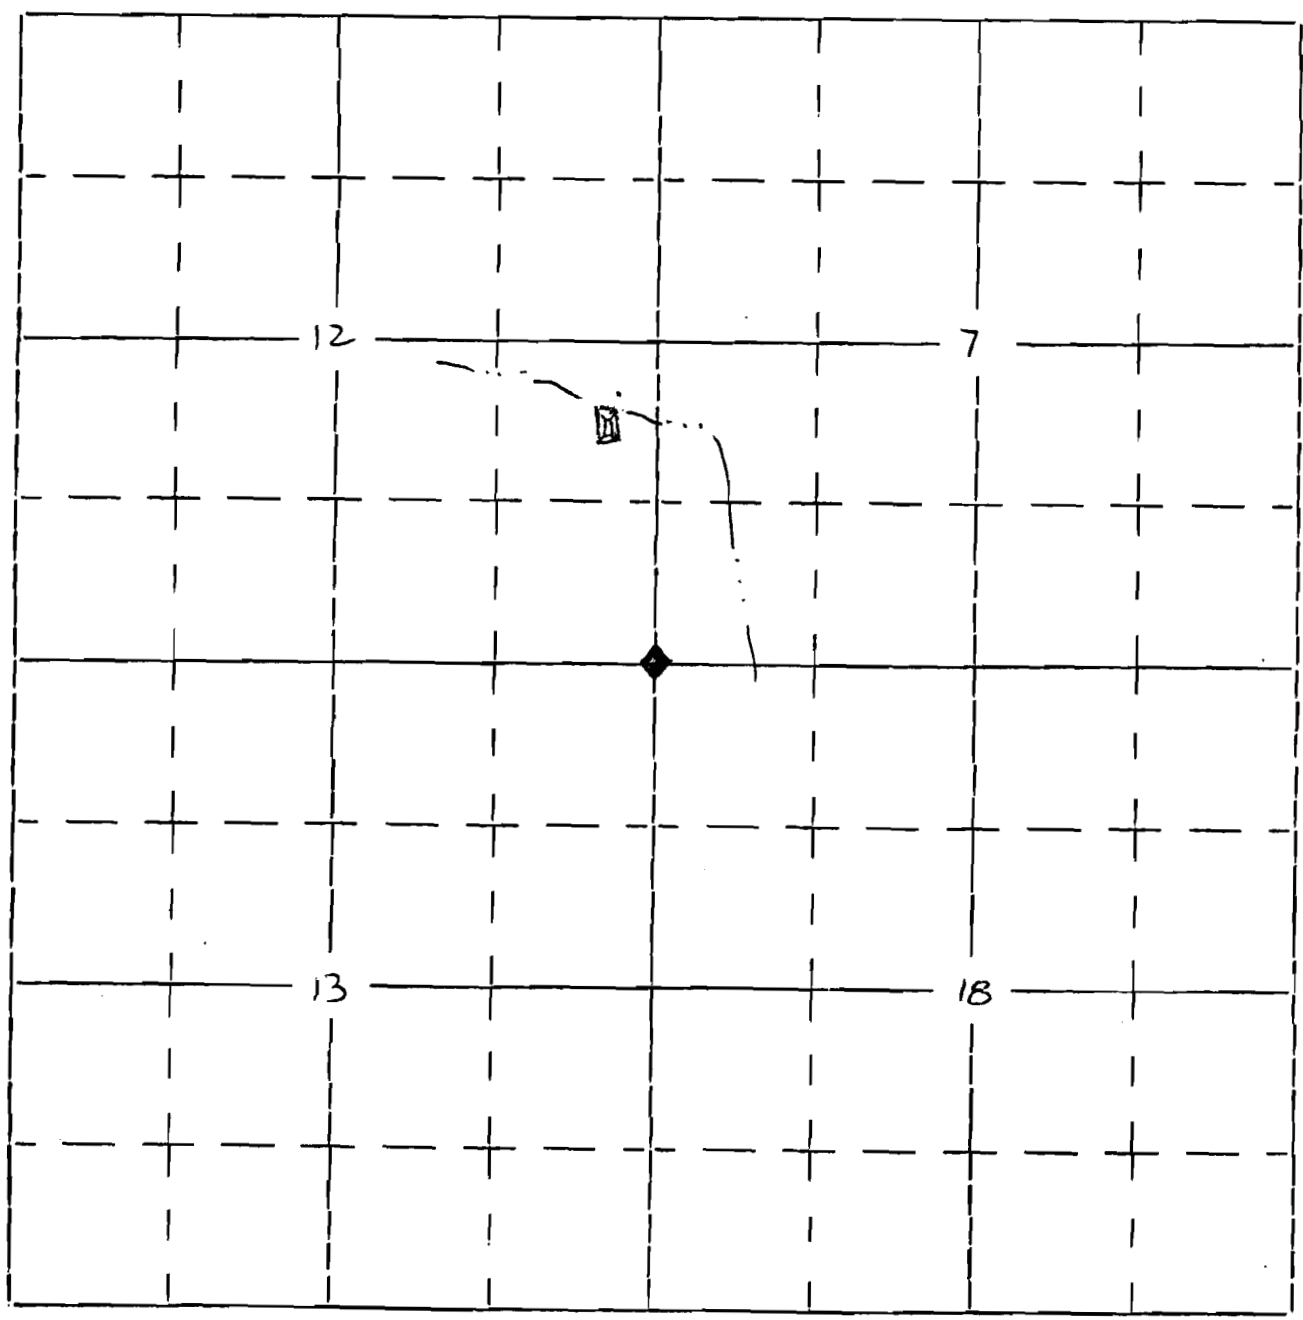

Project is located 1968' north and 375' west of corner Common
to 12, 13 & 7, 18.