

R-9410
62554

RECEIVED

SEP 2 1983

WATER RESOURCES DEPT.
SALEM, OREGON

Form OR-010-7300-2
4/83

UNITED STATES
DEPARTMENT OF THE INTERIOR
BUREAU OF LAND MANAGEMENT

Section

Township 40 S.


Appl. No. R-65834

13, 24 & 18, 19

Range 14 1/2 E. & 15 E.

Permit No. R 9410

Will. Mer.

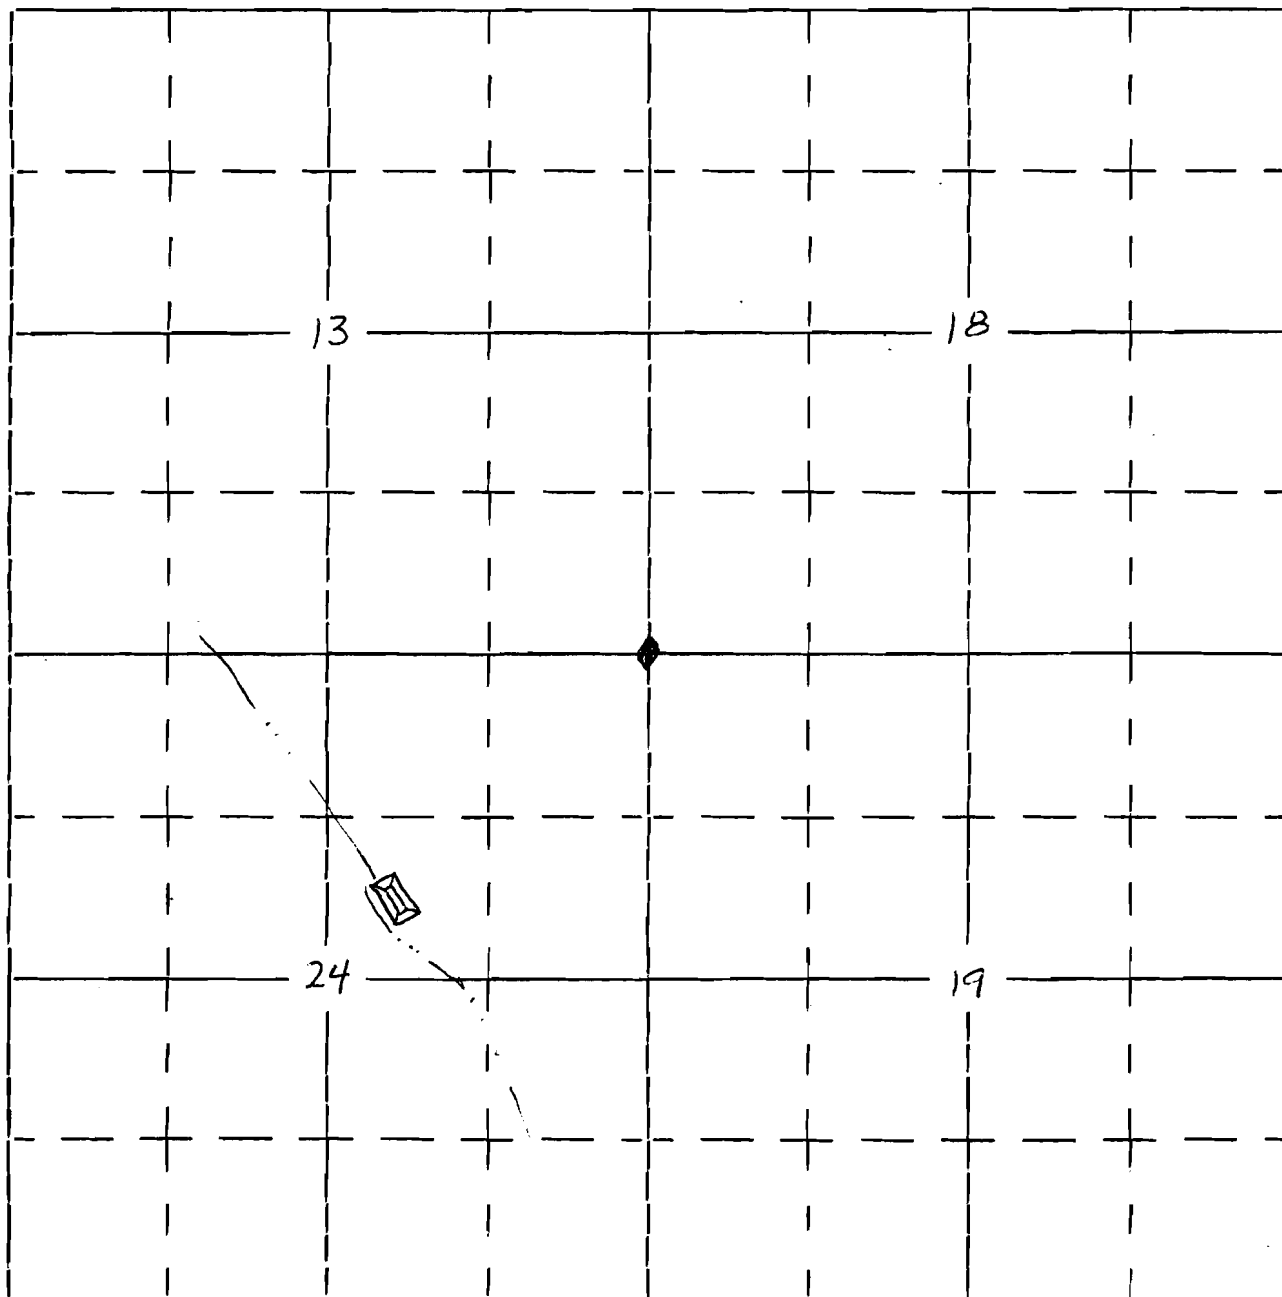

Project is located 2,093' south and 1,906' west of corner
Common to sections 13, 24 & 18, 19.