

R-9411
62555

RECEIVED

SEP 2 1983

Form OR-010-7300-2
4/83

UNITED STATES
DEPARTMENT OF THE INTERIOR
BUREAU OF LAND MANAGEMENT

WATER RESOURCES DEPT.
SALEM, OREGON

Section

32, 33, 4 & 5


Township 40 S.

Range 10 E.

Appl. No. R-65835

Permit No. R 9411

Will. Mer.

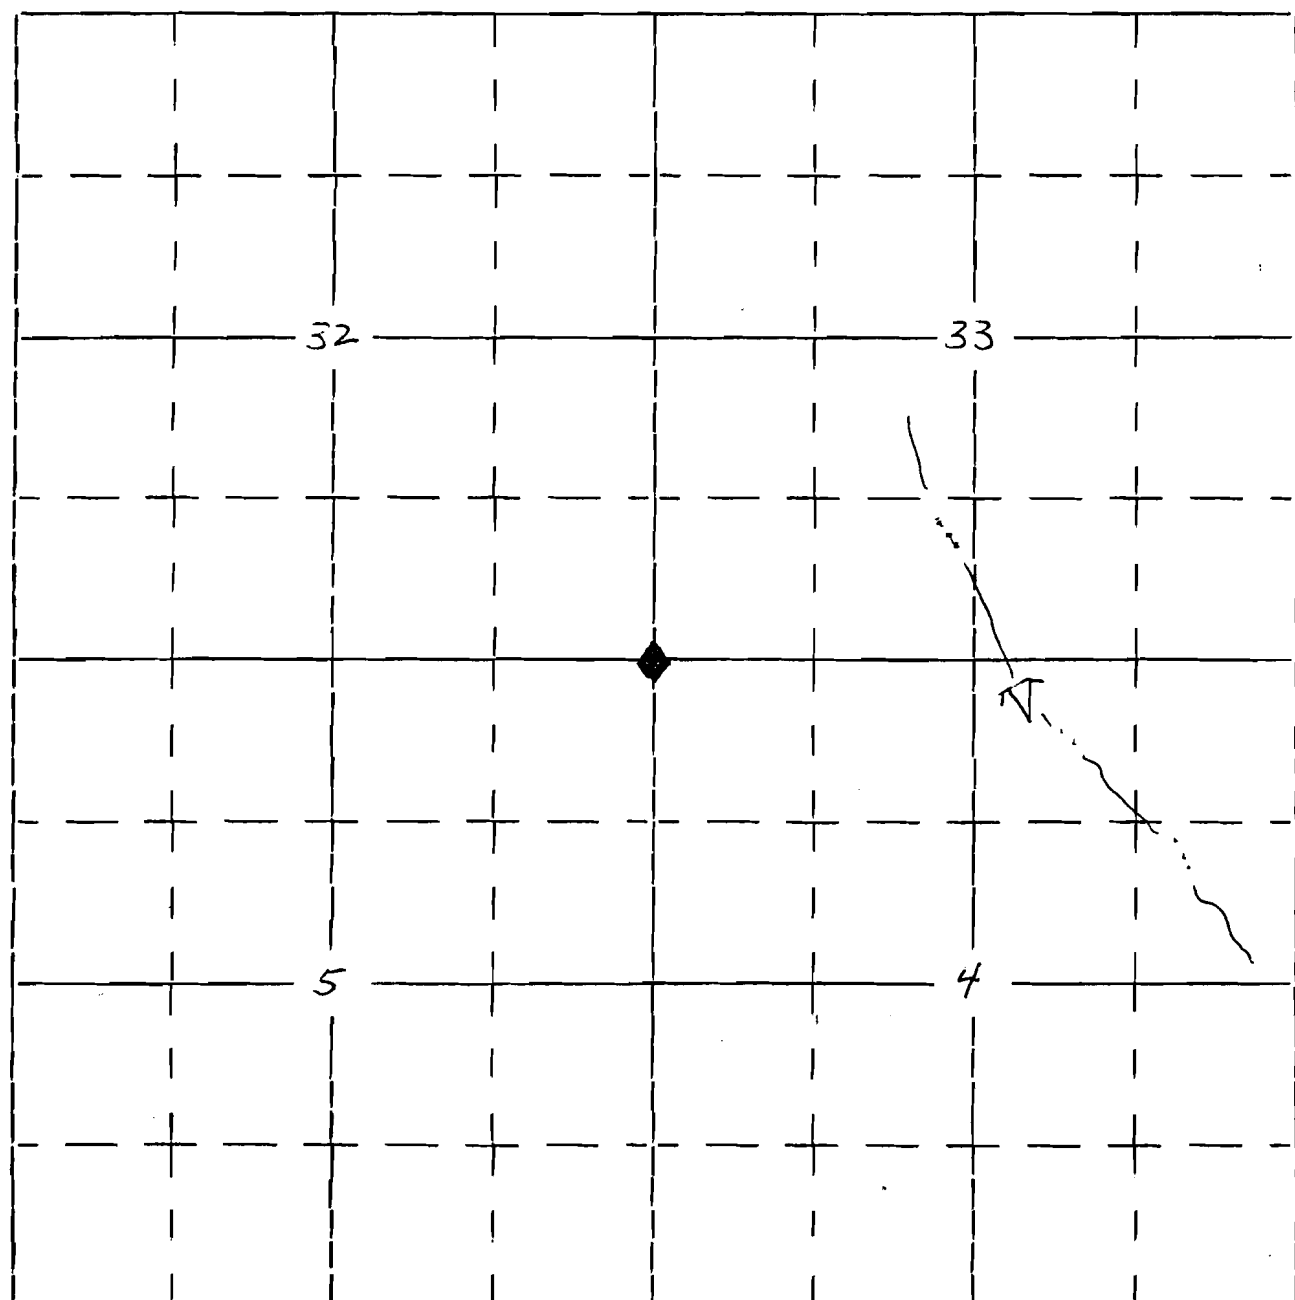

Project is located 2,999' east and 219' south of corner common to sections 32, 33, 4 & 5.