

R-9412

RECEIVED 62556

SEP 2 1983

WATER RESOURCES DEPT.
SALEM, OREGON

Form OR-010-7300-2
4/83

UNITED STATES
DEPARTMENT OF THE INTERIOR
BUREAU OF LAND MANAGEMENT

Section

Township 40 S.
41 S.


Appl. No. R-65836

31, 32, 5 & 6

Range 13 E.

Permit No. R 9412

Will. Mer.

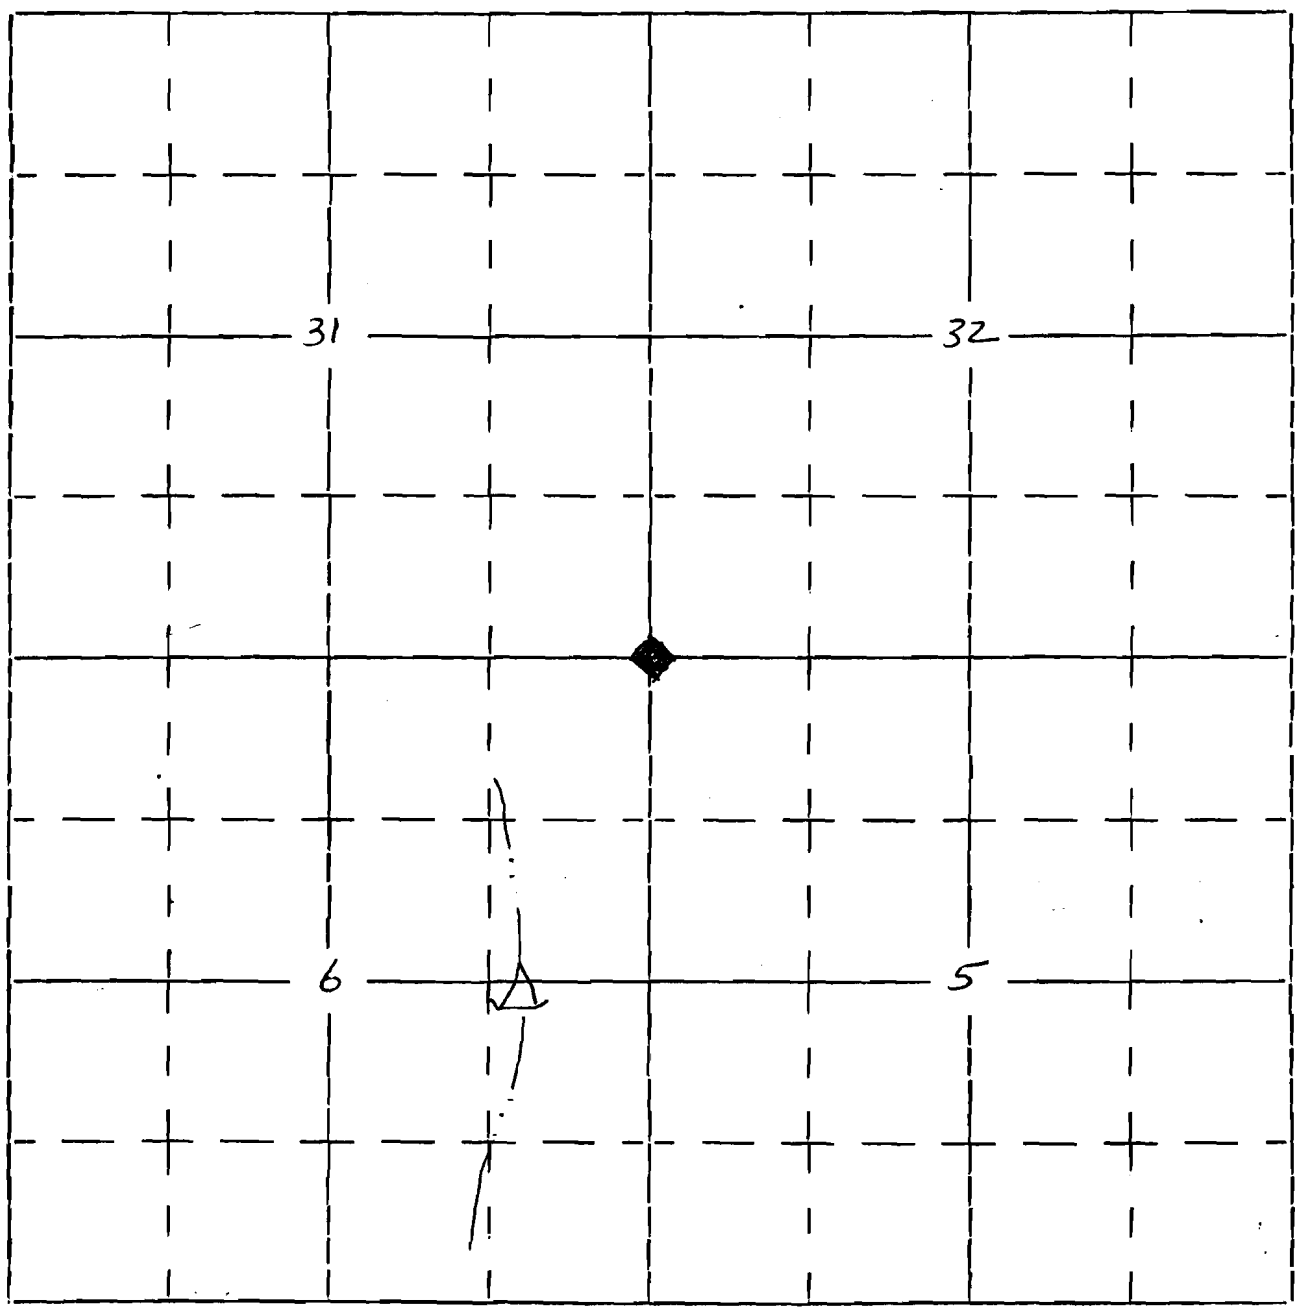

Project is located 2,744' south and 1,163' west of corner
Common to sections 31, 32 & 5 & 6.