

R-9413
RECEIVED 62557

SEP 2 1983
WATER RESOURCES DEPT.
SALEM, OREGON

Form OR-010-7300-2
4/83

UNITED STATES
DEPARTMENT OF THE INTERIOR
BUREAU OF LAND MANAGEMENT

Section

Township 41 S.


Appl. No. R-65837

8, 9, 16, 17

Range 13 E.

Permit No. R 9413

Will. Mer.

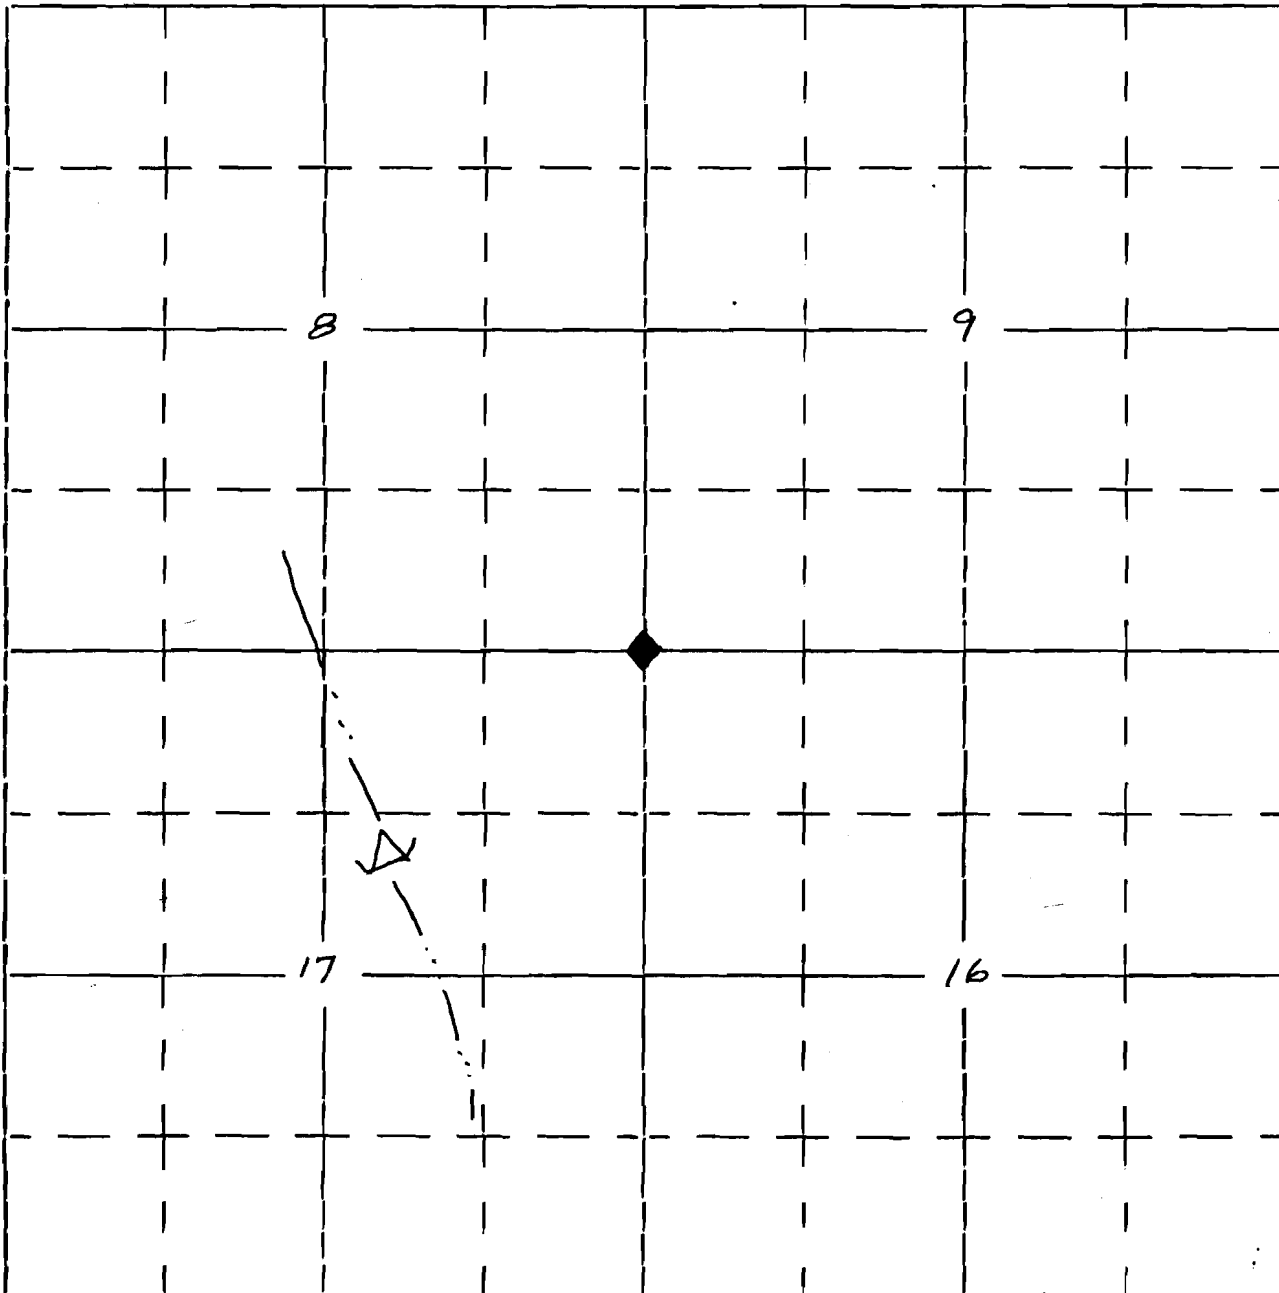

Project is located 2,499' west and 1,875' ^{south} of corner common to sections 8, 9, 16 & 17.