

R-9414
RECEIVED 62558

SEP 2 1983
WATER RESOURCES DEPT.
SALEM, OREGON

Form OR-010-7300-2
4/83

UNITED STATES
DEPARTMENT OF THE INTERIOR
BUREAU OF LAND MANAGEMENT

Section

Township 41 S.


Appl. No. R-65838

Permit No. R 9414

7, 8, 17 & 18

Range 13 E.

Will. Mer.

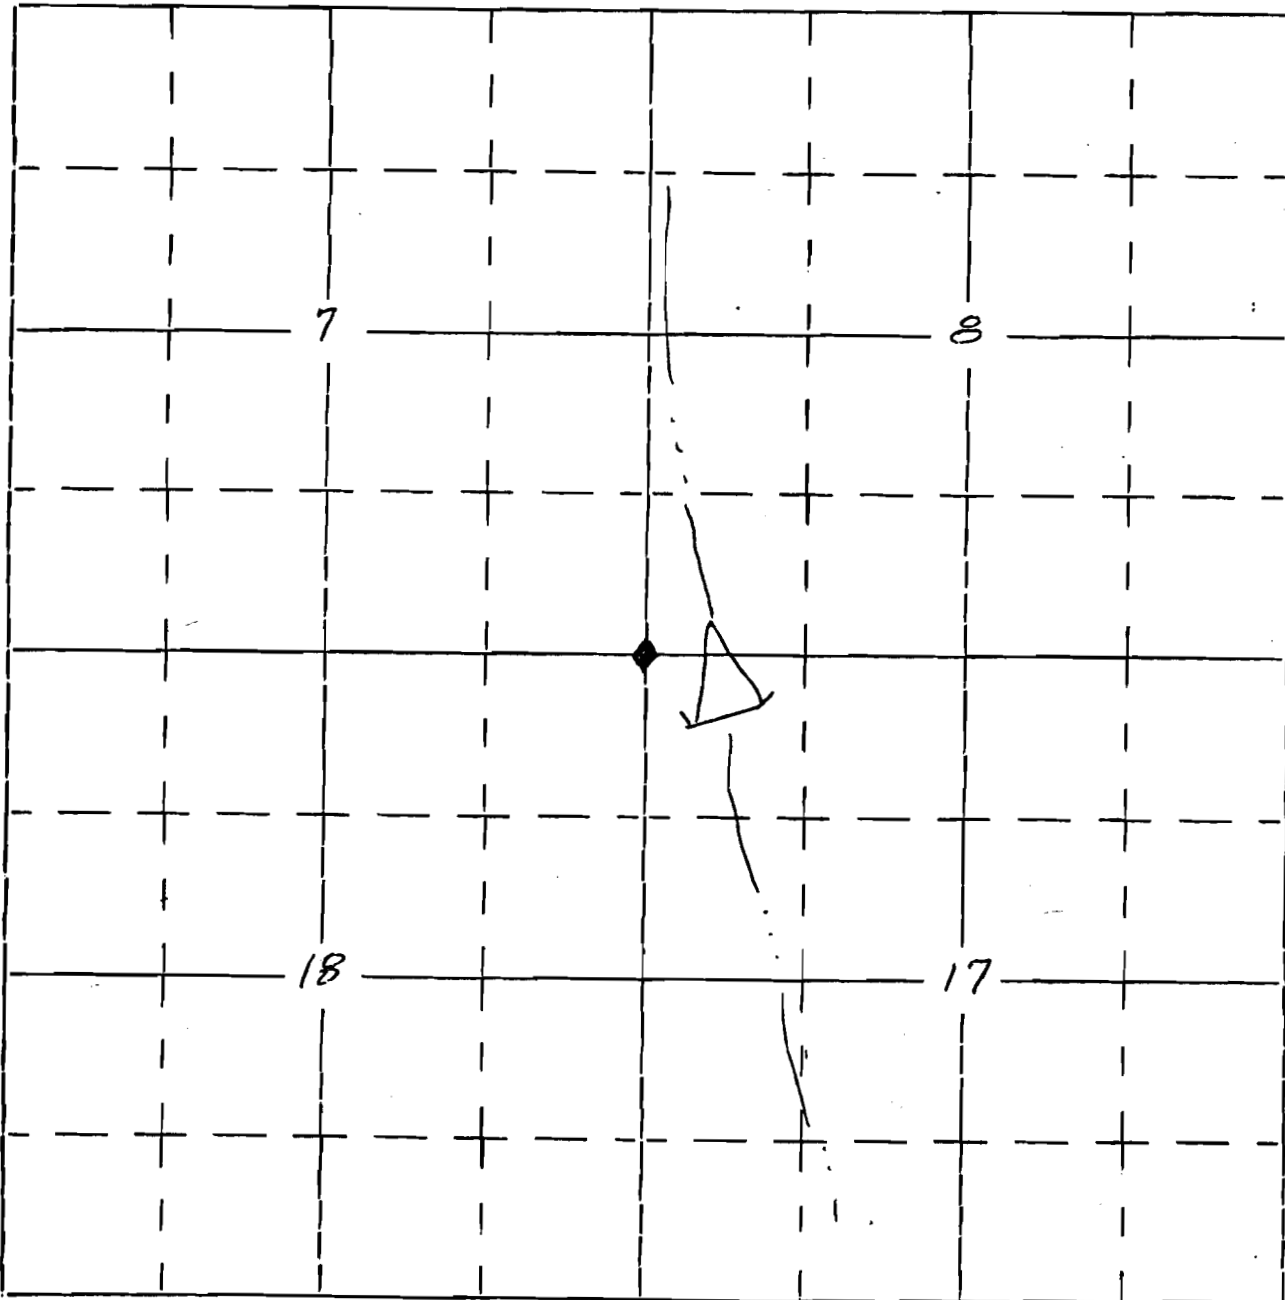

Project is located 469' east and 520 feet south of corner common
to sections 7, 8, 17, 18.