

RECEIVED ^{R-9415}
62559

SEP 2 1983
WATER RESOURCES DEPT.
SALEM, OREGON

Form OR-010-7300-2
4/83

UNITED STATES
DEPARTMENT OF THE INTERIOR
BUREAU OF LAND MANAGEMENT

Section

36, 1, 6 & 31


Township 40 & 41 S.

Range 12 & 13 E.

Appl. No. R-65839

Permit No. R 9415

Will. Mer.

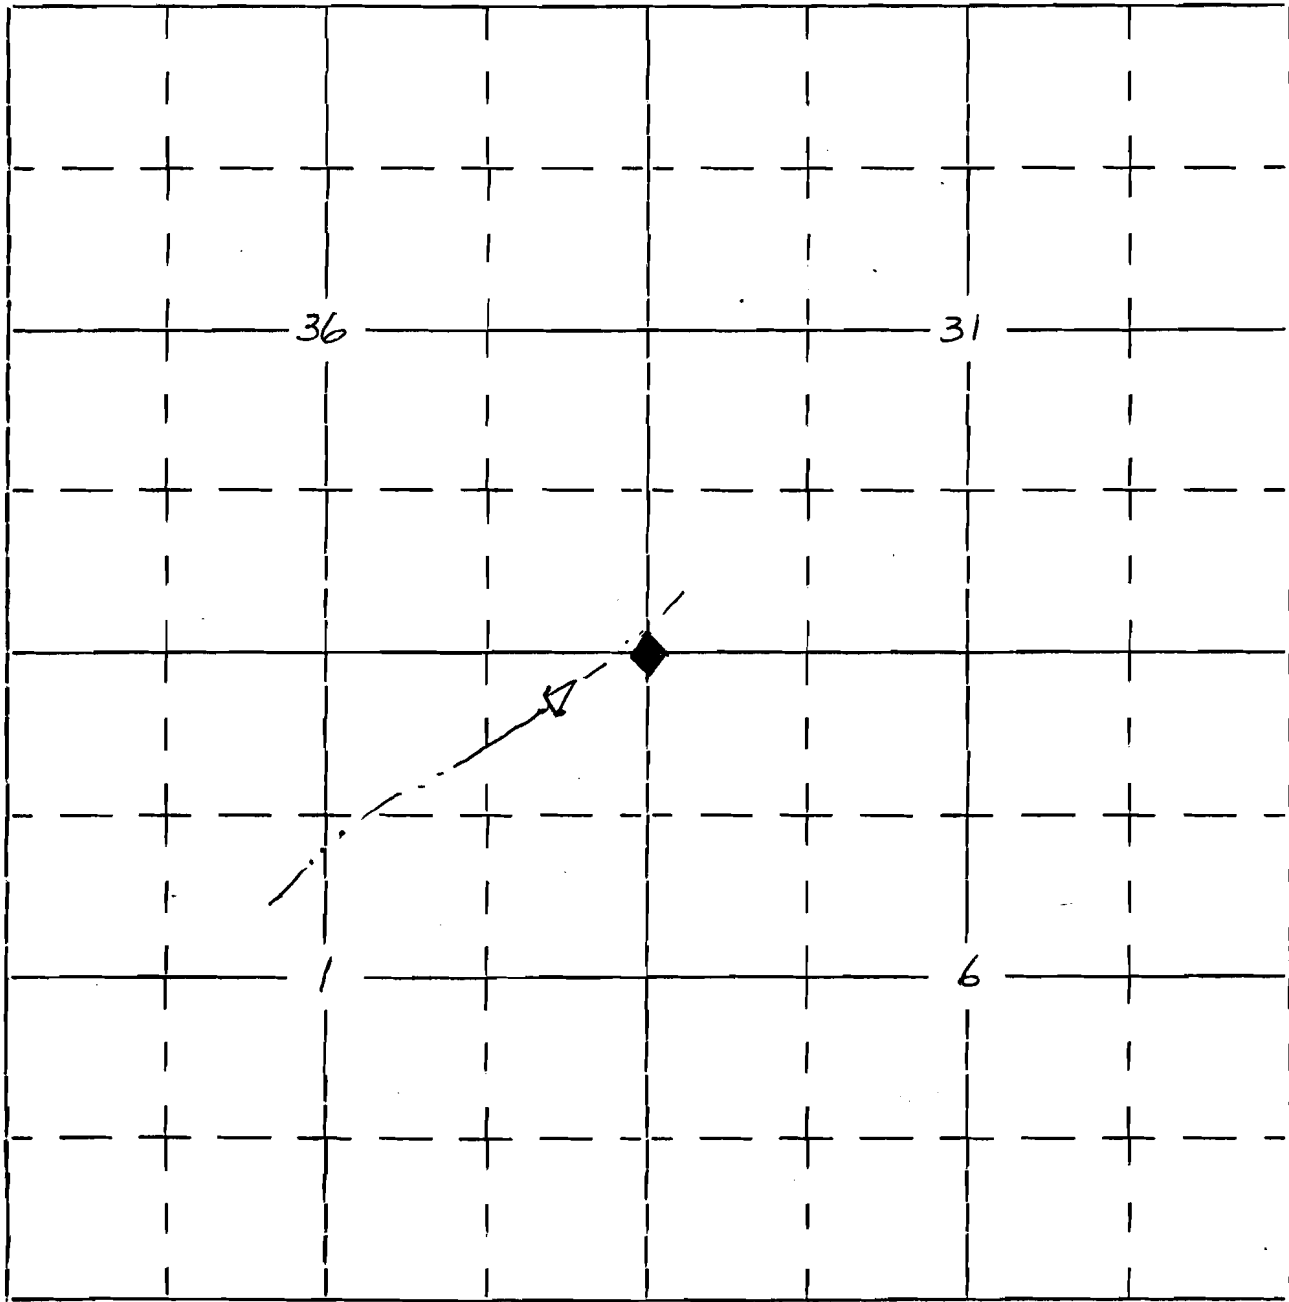

Project is located 375' west and 312' south of corner common to sections 36, 1, 6 & 31.