

RECEIVED R-9416 62560

Form OR-010-7300-2
4/83

UNITED STATES
DEPARTMENT OF THE INTERIOR
BUREAU OF LAND MANAGEMENT

SEPT 2 1983
WATER RESOURCES DEPT.
SALEM, OREGON

Section

29, 30, 31 & 32


Township 40 S.

Range 15 E.

Will. Mer.

Appl. No. R-65840

Permit No. R 9416

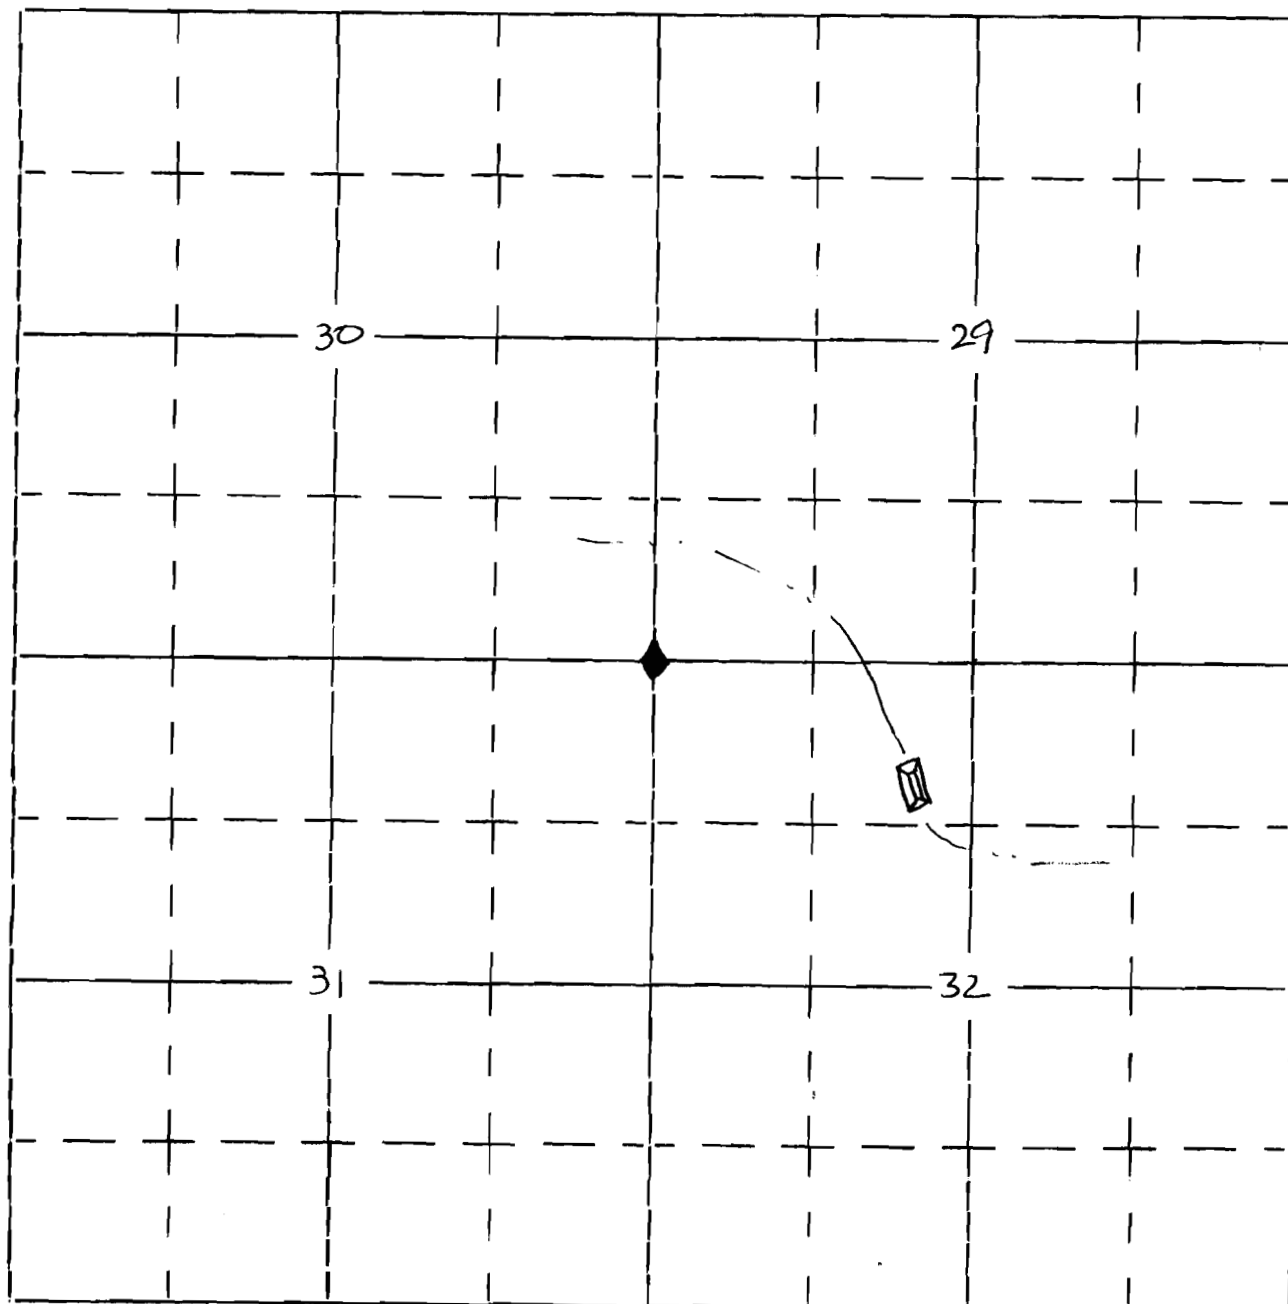

Project is located 2,312' east and 1,125' south of the corner common to sections 29, 30, 31, & 32.