

RECEIVED R-9417
62561
SEP 2 1983
WATER RESOURCES DEPT.
SALEM, OREGON

Form OR-010-7300-2
4/83

UNITED STATES
DEPARTMENT OF THE INTERIOR
BUREAU OF LAND MANAGEMENT

Section

Township 40 S.


Appl. No. R-65841

12, 13 & 7, 18

Range 14 $\frac{1}{2}$ & 15 E.

Permit No. R 9417

Will. Mer.

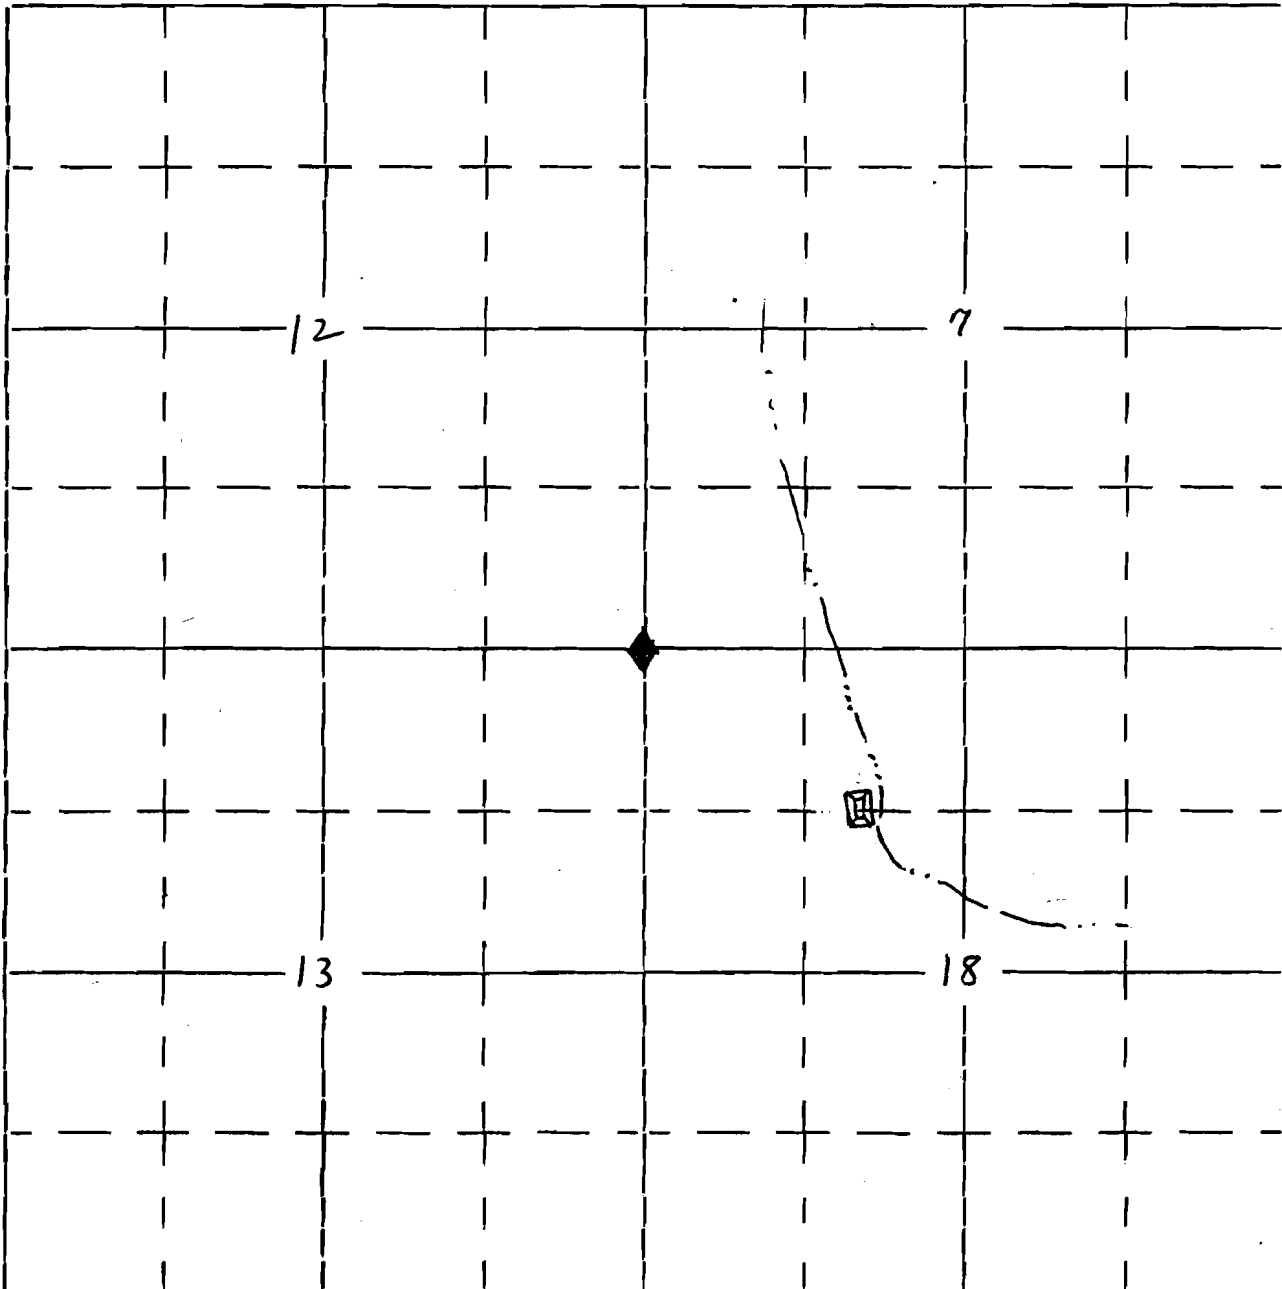

Project is located 1,875' east and 1,250' south of corner
common to sections 12, 13 & 7, 18.