

R-9419
RECEIVED 62562

SEP 2 1983

Form OR-010-7300-2
4/83

UNITED STATES
DEPARTMENT OF THE INTERIOR
BUREAU OF LAND MANAGEMENT

WATER RESOURCES DEPT.
SALEM, OREGON

Section

Township 40 S.


Appl. No. R-65843

11, 12, 13 & 14

Range 14 E.

Permit No. R 9419

Will. Mer.

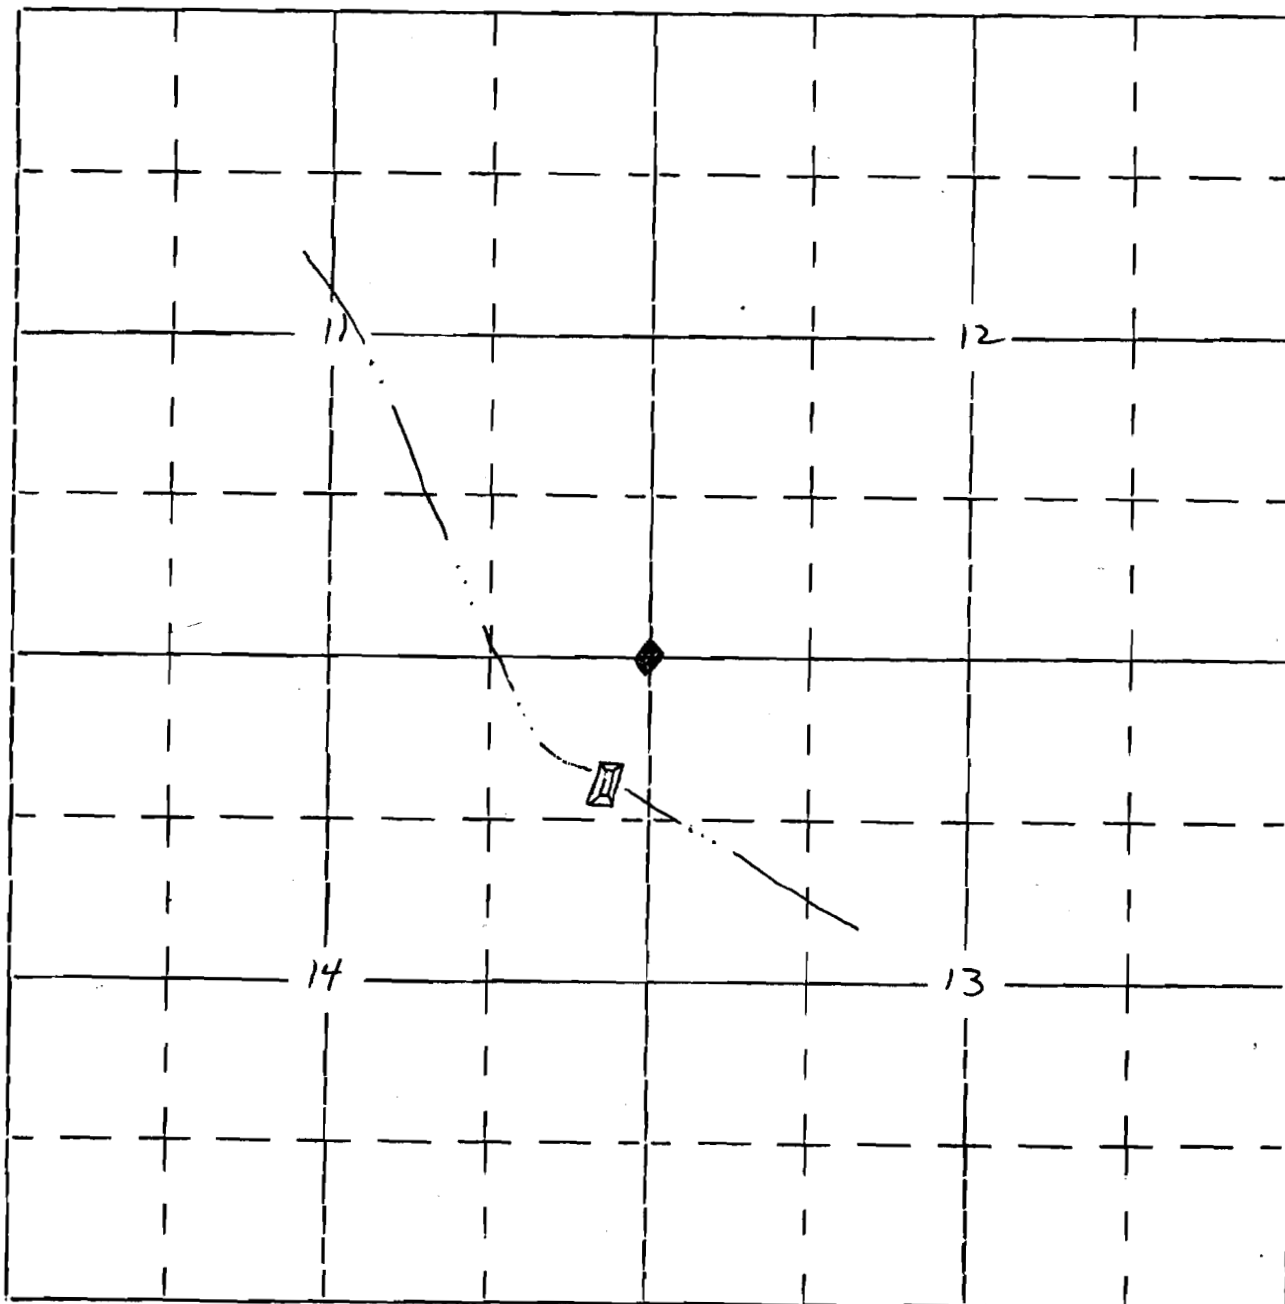

Project is located 1,155' south and 330' west of corner common
to sections 11, 12, 13 & 14.