

Form OR-010-7300-2
4/83

UNITED STATES
DEPARTMENT OF THE INTERIOR
BUREAU OF LAND MANAGEMENT

R-9421
RECEIVED *62563*
SEP 2 1983
WATER RESOURCES DEPT.
SALEM, OREGON

Section

20, 21, 28, 29


Township 40 S

Range 12 E

Will. Mer.

Appl. No. R-65845

Permit No. R 9421

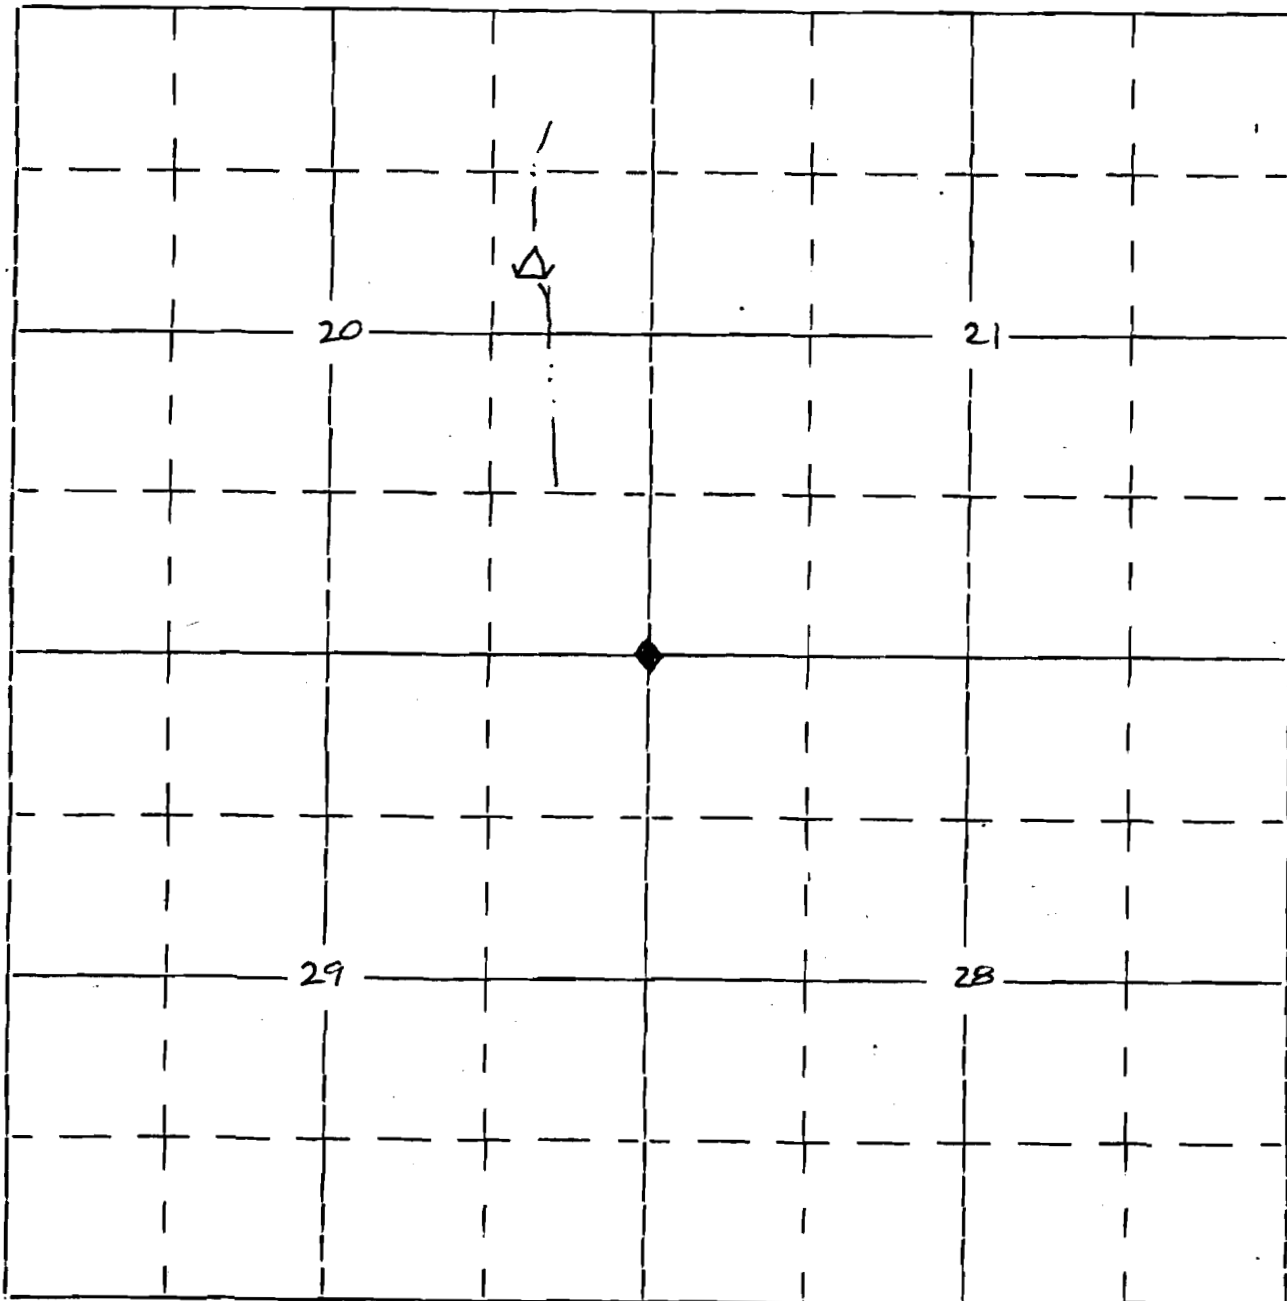

Project is located 3,124' north and 1,062' west of corner common to sections 20, 21, 28 & 29.