

R-9422
62564

RECEIVED

SEP 2 1983

WATER RESOURCES DEPT.
SALEM, OREGON

Form OR-010-7300-2
4/83

UNITED STATES
DEPARTMENT OF THE INTERIOR
BUREAU OF LAND MANAGEMENT

Section
3, 4, 9, 10


Township 41S

Appl. No. R-65846

Range 15E

Permit No. R 9422

Will. Mer.

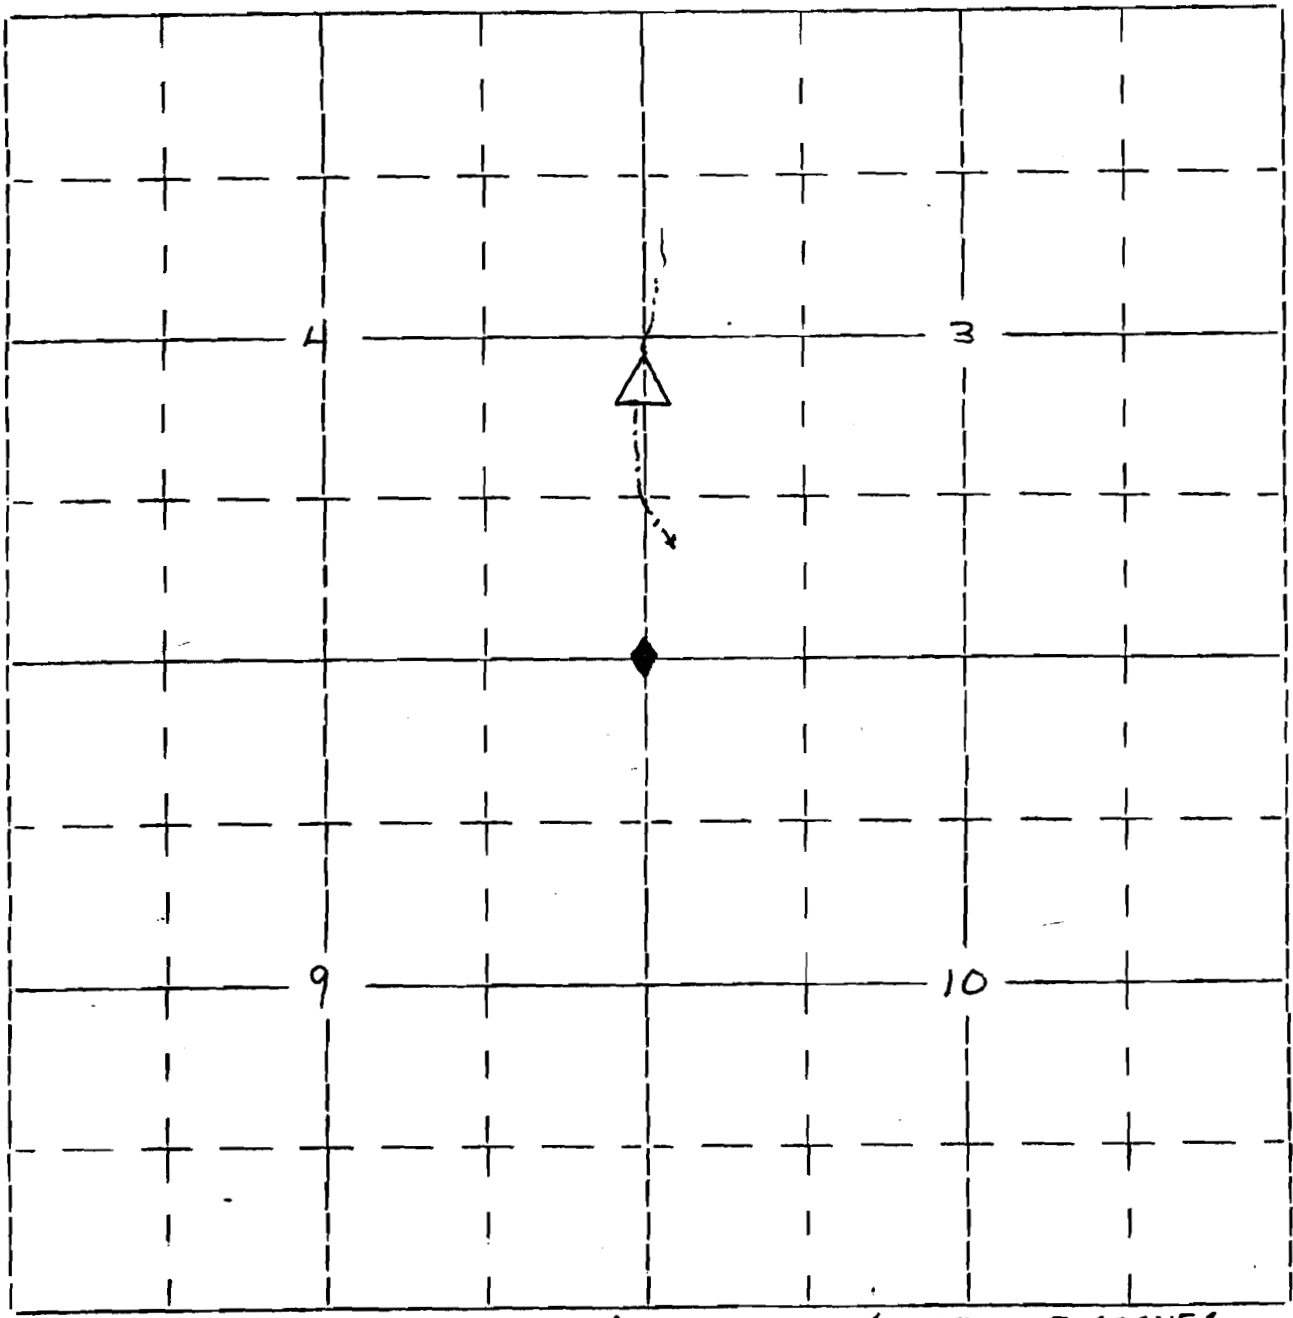

RESUR. COMMON TO SECTIONS 3 & 4 IS 2040' NORTH OF CORNER
COMMON TO SECTIONS 3, 4, 9, 10