

R-9423  
62565

RECEIVED

SEP 2 1983  
WATER RESOURCES DEPT.  
SALEM, OREGON

Form OR-010-7300-2  
4/83

UNITED STATES  
DEPARTMENT OF THE INTERIOR  
BUREAU OF LAND MANAGEMENT

Appl. No. R-65847


Permit No. R 9423

Section  
17, 18, 19, 20

Township 41S

Range 15E

Will. Mer.

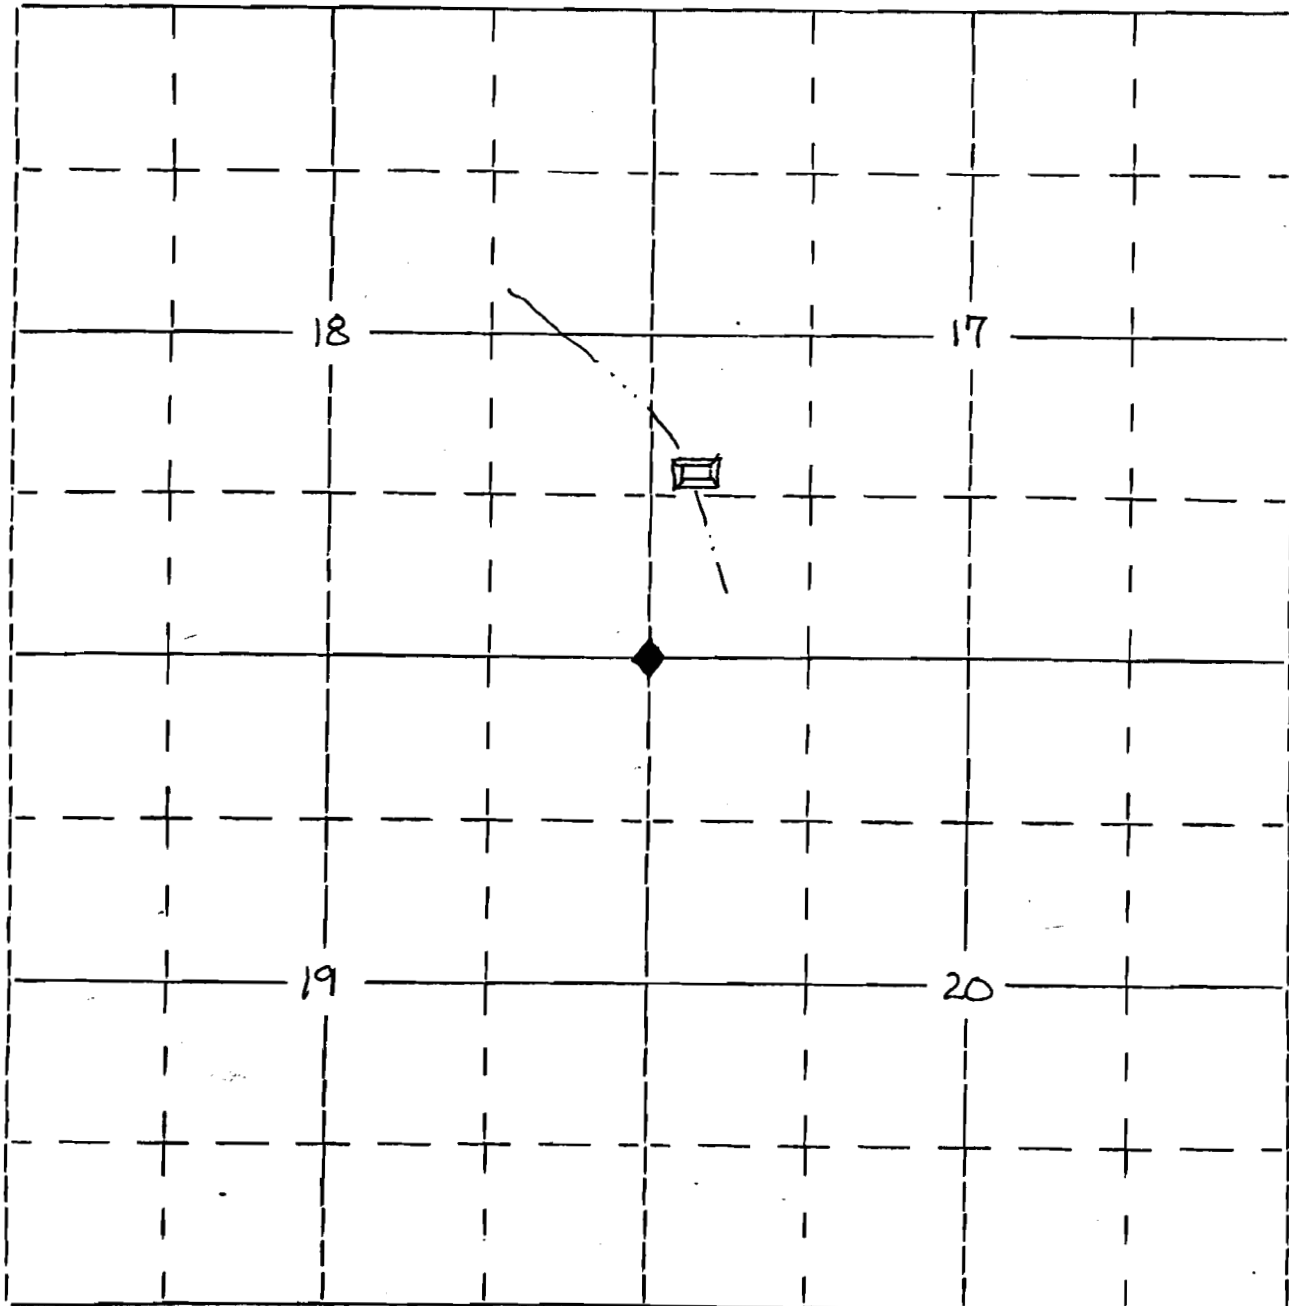

WATERHOLE IS 1485' NORTH AND 330' EAST OF CORNER COMMON  
TO SECTIONS 17, 18, 19, 20